


STATE OF KANSAS
STATE CORPORATION COMMISSION

Give All Information Completely
Make Required Affidavit
Mail or Deliver Report to:
Conservation Division
State Corporation Commission
311 No. Broadway
Wichita, Kansas

15-137-00270-00-00 Form CR-4

WELL PLUGGING RECORD

NORTH

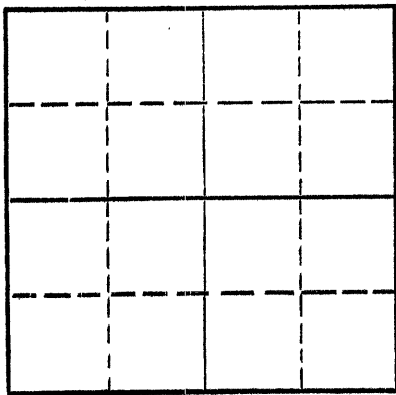

Locate well correctly on above
Section Plat

Norton County. Sec. 23 Twp. 25 Rge. (E) 25 (W)
Location as "NE/CNWxSWx" or footage from lines C NW NW NW
Lease Owner W.W. Sauvage
Lease Name Preston Well No. 1
Office Address Oberlin, Kansas.
Character of Well (completed as Oil, Gas or Dry Hole) Dry Hole
Date well completed 12-18- 1963
Application for plugging filed 12-19- 1963
Application for plugging approved 19
Plugging commenced 12-26- 1963
Plugging completed 12-26- 1963
Reason for abandonment of well or producing formation Dry Hole

If a producing well is abandoned, date of last production 19
Was permission obtained from the Conservation Division or its agents before plugging was commenced? Yes

Name of Conservation Agent who supervised plugging of this well Bill Nichols, Morland, Kansas
Producing formation Depth to top Bottom Total Depth of Well 3825 Feet
Show depth and thickness of all water, oil and gas formations.

OIL, GAS OR WATER RECORDS

CASING RECORD

FORMATION	CONTENT	FROM	TO	SIZE	PUT IN	PULLED OUT
sand				8 5/8	270	none

Describe in detail the manner in which the well was plugged, indicating where the mud fluid was placed and the method or methods used in introducing it into the hole. If cement or other plugs were used, state the character of same and depth placed, from feet to feet for each plug set.

From bottom filled with heavy Mud to 540 ft. Set Plug with 1/2 sax hulls and 20 sax Cement, filled with heavy Mud to 260 ft. Set Plug with 20 sax Cement, filled with heavy mud to 40 ft. Set plug with 1/2 sax hulls and 10 sax Cement and filled to top of hole with heavy Mud.

RECEIVED
STATE CORPORATION COMMISSION

DEC 30 1963

12-30-63
CONSERVATION DIVISION
Wichita, Kansas

(If additional description is necessary, use BACK of this sheet)
Name of Plugging Contractor Sauvage Drilling Co., Inc.
Address Oberlin, Kansas.

STATE OF Kansas, COUNTY OF Decatur, ss.

(employee of owner) or (owner or operator) of the above-described well, being first duly sworn on oath, says: That I have knowledge of the facts, statements, and matters herein contained and the log of the above-described well as filed and that the same are true and correct. So help me God.

(Signature) [Signature]

(Address)

SUBSCRIBED AND SWORN to before me this 25 day of Dec, 1963

My commission expires Feb 12 - 1965

Notary Public.

15-137-00270-0000

DRILLERS LOG

⤴

Operator Sauvage Drilling Co. Inc.

Location . . . CNWNNW 23-2S-25W

Lease Name . . . Preston

Norton County, Kansas

Contractor . . . Company Tools

Casing Record - - 270 Ft.

Rotary Commenced - - 12-9-63

8 5/8" Surface Casing

Rotary Completed - - 12-18-63

Figures Denote Bottom of Formation

Shale 614
Sand 1250
Shale 1730
Shale & Sand 1965
Shale 2040
Anhydrite 2066
Shale 2495
Lime 2595
Lime & Shale 2586
Lime 3030
Lime & Shale 3823
Granite 3825 TD

RECEIVED
STATE CORPORATION COMMISSION

DEC 30 1963
12-30-63
CONSERVATION DIVISION
Wichita, Kansas

State of Kansas)
) SS
Decatur County)

I hereby certify that the foregoing is, to the best of my knowledge and belief, a true and correct drilling log as shown by the drilling reports in connection with the aforesaid well.



Subscribes and sworn to before me, the undersigned, a Notary Public, this
25 day of December 1963.

My commission expires Feb 12 - 1965.

