


WELL PLUGGING RECORD

Give All Information Completely  
Make Required Affidavit  
Mail or Deliver Report to:  
Conservation Division  
State Corporation Commission  
800 Bitting Building  
Wichita, Kansas

NORTH

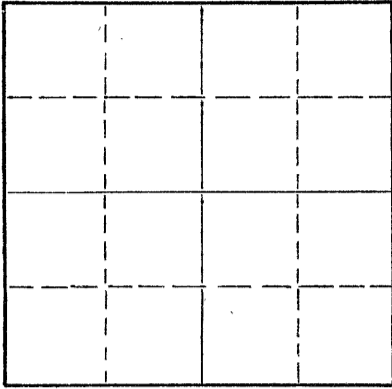

Locate well correctly on above  
Section Plat

Norton County. Sec. 4 Twp. 2S Rge. 25 ~~(E)X~~ (W)  
Location as "NE/CNW $\frac{1}{4}$ SW $\frac{1}{4}$ " or footage from lines NW/4 NW/4 NW/4  
Lease Owner Barnett Oil Company, Et Al  
Lease Name Sebaugh Well No. 1  
Office Address 411 First Natl. Bank Bldg., Wichita, Kansas  
Character of Well (completed as Oil, Gas or Dry Hole) Dry Hole  
Date well completed 4-17- 19 56  
Application for plugging filed 4-17- 19 56  
Application for plugging approved 4-18- 19 56  
Plugging commenced 4-17- 19 56  
Plugging completed 4-17- 19 56  
Reason for abandonment of well or producing formation Dry Hole

If a producing well is abandoned, date of last production - - 19 -  
Was permission obtained from the Conservation Division or its agents before plugging was commenced? Yes

Name of Conservation Agent who supervised plugging of this well Eldon Petty  
Producing formation \_\_\_\_\_ Depth to top \_\_\_\_\_ Bottom \_\_\_\_\_ Total Depth of Well 3693 Feet  
Show depth and thickness of all water, oil and gas formations.

OIL, GAS OR WATER RECORDS

CASING RECORD

FORMATION	CONTENT	FROM	TO	SIZE	PUT IN	PULLED OUT
				8 5/8"	198'	-0-

Describe in detail the manner in which the well was plugged, indicating where the mud fluid was placed and the method or methods used in introducing it into the hole. If cement or other plugs were used, state the character of same and depth placed, from \_\_\_\_\_ feet to \_\_\_\_\_ feet for each plug set.

Filled hole with mud to 190'; set plug at 190' with 1/2 sack of hulls on top; put 15 sacks of cement on top of hulls; filled with mud to 40'; set plug at 40' and wired it - with 1/2 sack of hulls on top; put 10 sacks of cement on top of hulls to bottom of cellar.

(Well Log Attached)

(If additional description is necessary, use BACK of this sheet)  
Name of Plugging Contractor Barnett Drilling, Inc.  
Address 409 First Natl. Bank Bldg., Wichita, Kansas

STATE OF Kansas, COUNTY OF Norton, ss.  
F. H. Rousey (employee of owner or owner or operator) of the above-described well, being first duly sworn on oath, says: That I have knowledge of the facts, statements, and matters herein contained and the log of the above-described well as filed and that the same are true and correct. So help me God.

(Signature) F. H. Rousey  
411 First Nat'l Bank Bldg., Wichita, Kansas  
(Address)

SUBSCRIBED AND SWORN TO before me this 20th day of April, 1956

My commission expires February 27, 1960. Millard F. Willis Notary Public.

**PLUGGING**  
FILE SEC 4 T 2 R 25W  
BOOK PAGE 54 LINE 24

APR 21 1956  
CONSERVATION DIVISION  
Wichita, Kansas  
4-21-56

BARNETT OIL COMPANY  
 WELL LOG - SEBAUGH NO. 1  
 NW/4 NW/4 NW/4 OF SECTION 4-2S-25W  
 NORTON COUNTY, KANSAS

Started: 4-9-56  
 Completed: 4-17-56

<u>From</u>	<u>To</u>	<u>Formation</u>
0	65	Surface Clay
65	80	Sand
80	120	Clay
120	140	Sand
140	170	Clay
170	198	Blue Shale
198	1945	Shale
1945	1985	Anhydrite
1985	2210	Shale and Shells
2210	2730	Shale
2730	3375	Shale and Lime
3375	3392	Lime
3392	3470	Lime and Shale
3470	3540	Lime
3540	3657	Lime and Shale
3657	3693	Lime (Total Depth)

CERTIFICATE


I, F. H. Rousey, Office Manager of Barnett Oil Company, hereby certify that to the best of my knowledge and belief, the above is a true and correct log of the Sebaugh Well No. 1, located in the NW/4 NW/4 NW/4 of Section 4-2S-25W, Norton County, Kansas.

*F. H. Rousey*

Subscribed and sworn to before me, in and for the County of Sedgwick, State of Kansas, this 20th day of April, 1956.

*Mildred F. Willis*  
 Notary Public

My commission expires: February 27, 1960.

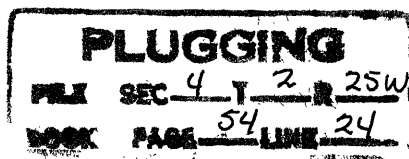

4-21-56