

15-137-00264-00-00

STATE OF KANSAS  
STATE CORPORATION COMMISSION


Form CP-4

WELL PLUGGING RECORD

Give All Information Completely  
Make Required Affidavit  
Mail or Deliver Report to:  
Conservation Division  
State Corporation Commission  
211 No. Broadway  
Wichita, Kansas

Norton County, Sec. 1 Twp. 25 Rge. 25 ( W) (W)  
Location as "NE/CNW/SW" or footage from lines C/SE NW  
Lease Owner Reading & Bates Offshore Drilling Company  
Lease Name Lecount Well No. 1  
Office Address 1101 Philtower Bldg., Tulsa 3, Oklahoma  
Character of Well (completed as Oil, Gas or Dry Hole) D&A  
Date well completed Dec. 16 19 62  
Application for plugging filed Dec. 21 19 62  
Application for plugging approved Dec. 16 19 62  
Plugging commenced Dec. 16 19 62  
Plugging completed Dec. 19 62  
Reason for abandonment of well or producing formation Dry Hole

NORTH

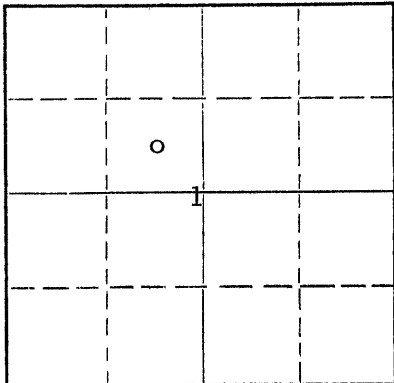

Locate well correctly on above  
Section Plat

If a producing well is abandoned, date of last production NA 19       
Was permission obtained from the Conservation Division or its agents before plugging was commenced? Yes

Name of Conservation Agent who supervised plugging of this well Eldon Petty, Hayes Office  
Producing formation NA Depth to top      Bottom      Total Depth of Well 3712 Feet  
Show depth and thickness of all water, oil and gas formations.

OIL, GAS OR WATER RECORDS

CASING RECORD

FORMATION	CONTENT	FROM	TO	SIZE	PUT IN	PULLED OUT
				8 5/8	279'	none

Describe in detail the manner in which the well was plugged, indicating where the mud fluid was placed and the method or methods used in introducing it into the hole. If cement or other plugs were used, state the character of same and depth placed, from      feet to      feet for each plug set.

20 sx cement spotted at 550 feet  
20 sx cement spotted at 240 feet  
10 sx cement spotted at 40 feet

RECEIVED  
STATE CORPORATION COMMISSION  
DEC 26 1962  
12-26-62  
CONSERVATION DIVISION  
Wichita, Kansas

(If additional description is necessary, use BACK of this sheet)

Name of Plugging Contractor Murfin Drilling Company  
Address Union Center Wichita, Kansas

STATE OF OKLAHOMA, COUNTY OF TULSA, ss.  
D. L. Potter (employee of owner) or (~~owner or operator~~) of the above-described well, being first duly sworn on oath, says: That I have knowledge of the facts, statements, and matters herein contained and the log of the above-described well as filed and that the same are true and correct. So help me God.

(Signature) D. L. Potter  
1101 Philtower Bldg., Tulsa 3, Oklahoma  
(Address)

SUBSCRIBED AND SWORN TO before me this 21st day of December, 19 62

My commission expires      My Commission Expires Oct. 12, 1966 M. N. Pagarubis Notary Public.

