


STATE OF KANSAS
STATE CORPORATION COMMISSION

15-137-20269-00-00

WELL PLUGGING RECORD

Give All Information Completely
Make Required Affidavit
Mail or Deliver Report to
Conservation Division
State Corporation Comm.
245 North Water
Wichita, KS 67202

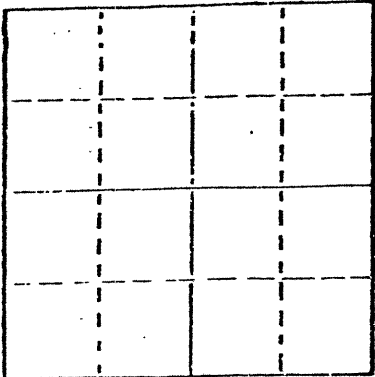

Locate well correctly on above
Section Plat

Norton County. Sec. 10 Twp. 2S Rge. 24
Location as "NE/CNW1SW1" or footage from lines
660' FNL & 330' FEL
Lease Owner SWENCO-Western, Inc.
Lease Name Thiele Well No. #1-10
Office Address 1337 Delaware St. - Suite 200, Denver, CO
Character of Well (Completed as Oil, Gas or Dry Hole)
Dry Hole

Date Well completed 12-21-82 19
Application for plugging filed 12-21-82 19
Application for plugging approved 12-21-82 19
Plugging commenced 12-21-82 19
Plugging completed 12-21-82 19
Reason for abandonment of well or producing formation
Commercial quantities of oil not found
If a producing well is abandoned, date of last production 19.

Was permission obtained from the Conservation Division or
its agents before plugging was commenced? Yes

Name of Conservation Agent who supervised plugging of this well Carl Goodrow
Producing formation Depth to top Bottom Total Depth of Well 3754'
Show depth and thickness of all water, oil and gas formations.

OIL, GAS OR WATER RECORDS

CASING RECORD

| FORMATION | CONTENT | FROM | TO | SIZE | PUT IN | PULLED OUT |
|-----------|---------|------|----|--------|---------|------------|
| | | | | 8 5/8" | 251.62' | None |
| | | | | | | |
| | | | | | | |
| | | | | | | |

Describe in detail the manner in which the well was plugged, indicating where the mud fluid
was placed and the method or methods used in introducing it into the hold. If cement or other
plugs were used, state the character of same and depth placed, from feet to
feet for each plug set.

Plug @ 2200' w/20 sx.
Plug @ 1200' w/100 sx.
Plug @ 250' w/40 sx.
Plug @ 40' w/10 sx.
Rat Hole 10 sx.

STATE OF KANSAS
JAN 24 1983
WICHITA, KANSAS

1-24-83

(If additional description is necessary, use BACK of this sheet)

Name of Plugging Contractor Silverado Drilling, Inc.

STATE OF Kansas COUNTY OF Sedgwick, ss.
Joseph B. Brungardt, Jr., Acct. of Silverado Drilling, (employee of owner) or (owner or operator)
of the above-described well, being first duly sworn on oath, says: That I have knowledge of
the facts, statements, and matters herein contained and the log of the above-described well
as filed and that the same are true and correct. So help me God.

(Signature) Joseph B. Brungardt, Jr.
435 Page Court, 220 W. Douglas, Wichita, Ks. 67202
(Address)

SUBSCRIBED AND SWORN TO before me this 27 day of December, 1982



My commission expires 10-4-83

Juanita M. Green
Notary Public.

15-137-20269-00-00

DRILLER'S LOG

COMPANY: SWENCO-Western, Inc.

SEC. 10 T. 2S R. 24W

WELL NAME: Thiele #1-10

LOC. 660' FNL & 330' FEL

COUNTY: Norton

RIG NO. #8

TOTAL DEPTH 3754'

ELEVATION

COMMENCED: 12-13-82

COMPLETED: 12-21-82

CONTRACTOR: Silverado Drilling, Inc.

CASING RECORD:

SURFACE: 8 5/8" @ 251.62' w/125 sx. common, 2% gel, 3% cc.

PRODUCTION: D&A

LOG

(Figures Indicate Bottom of Formations)

| | |
|--------------------|------|
| Clay & Sand | 254 |
| Shale | 570 |
| Shale & Sand | 1965 |
| Shale | 2075 |
| Sand & Shale | 2384 |
| Shale | 2788 |
| Shale & Lime | 3754 |
| ROTARY TOTAL DEPTH | 3754 |

RECEIVED
STATE COOPERATION COMMISSION
JAN 24 1983
1-24-83
CONSERVATION DIVISION
Wichita, Kansas

STATE OF Kansas)
COUNTY OF Sedgwick) SS:

I, Joseph B. Brungardt, Jr., Acct. of Silverado Drilling, Inc.
upon oath state that the above and foregoing is a true and correct copy of the log of the
Thiele #1-10 well.

Joseph B. Brungardt, Jr.
Joseph B. Brungardt, Jr.

Subscribed and sworn to before me this 27 day of December, 1982.

My Appointment Expires:

10-4-83

Juanita M. Green
Juanita M. Green

