

15-137-00174-00-00

STATE OF KANSAS
STATE CORPORATION COMMISSION

Give All Information Completely
Make Required Affidavit
Mail or Deliver Report to:
Conservation Division
State Corporation Commission
212 North Market, Insurance Bldg.
Wichita, Kansas

WELL PLUGGING RECORD

Norton

County. Sec. 20 Twp. 2S Rge. 24W (E) (W)

Location as "NE/CNW/SW" or footage from lines 330' f/North & 990' f/W line NW/4

Lease Owner Sinclair Oil & Gas Company

Lease Name E. E. Thiele Well No. 1

Office Address Box 521, Tulsa, Oklahoma

Character of Well (completed as Oil, Gas or Dry Hole) Dry Hole

Date well completed 8-13-61 19__

Application for plugging filed 8-13-61 19__

Application for plugging approved 8-13-61 19__


Plugging commenced 8-13-61 19__

Plugging completed 8-14-61 19__

Reason for abandonment of well or producing formation Dry Hole

If a producing well is abandoned, date of last production 19__

Was permission obtained from the Conservation Division or its agents before plugging was commenced? _____

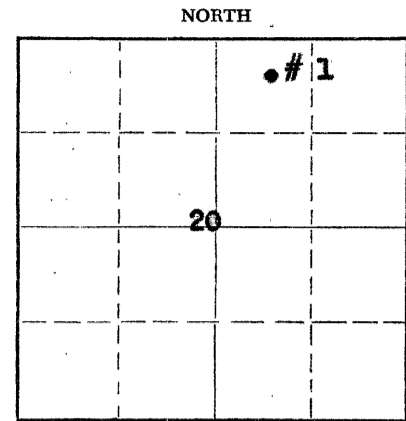

Locate well correctly on above Section Plat

Name of Conservation Agent who supervised plugging of this well Eldon Petty

Producing formation _____ Depth to top _____ Bottom _____ Total Depth of Well _____ Feet

Show depth and thickness of all water, oil and gas formations.

OIL, GAS OR WATER RECORDS

CASING RECORD

FORMATION	CONTENT	FROM	TO	SIZE	PUT IN	PULLED OUT
None encountered						

Describe in detail the manner in which the well was plugged, indicating where the mud fluid was placed and the method or methods used in introducing it into the hole. If cement or other plugs were used, state the character of same and depth placed, from _____ feet to _____ feet for each plug set.

Hole Plugged as follows; Mudded hole from TD 3775' to 540; ~~not~~ spotted 20 sacks cement from 540' to 475', mudded from 475' to 180', spotted 20 sacks cement from 180' to 125', mudded hole from 125' to surface with 10 sacks cement cap on top. Hole plugged as per Mr. Eldon Petty, State Plugger's instructions.

RECEIVED
STATE CORPORATION COMMISSION

AUG 21 1961 8-21-61

CONSERVATION DIVISION
Wichita, Kansas

Name of Plugging Contractor National Drilling Company (If additional description is necessary, use BACK of this sheet)
Address Wichita, Kansas

STATE OF Kansas, COUNTY OF Rice, ss. C. E. Most (employee of owner) or (owner or operator) of the above-described

well, being first duly sworn on oath, says: That I have knowledge of the facts, statements, and matters herein contained and the log of the above-described well as filed and that the same are true and correct. So help me God.

(Signature) C. E. Most Dist. Supt.
P. O. Box 466, Chase, Kansas (Address)

SUBSCRIBED AND SWORN TO before me this 18th day of August, 19 61

My commission expires 8-13-62
L. B. Reynolds Notary Public.

15-137-00174-00-00

KANSAS GEOLOGICAL SOCIETY
KANSAS WELL LOG BUREAU - KANSAS WELL SAMPLE BUREAU
KANSAS GEOLOGICAL SOCIETY BUILDING
508 EAST MURDOCK - WICHITA, KANSAS


COMPANY *Sinclair Oil & Gas*

SEC. 20 T. 2S R. 24W
LOG. NE NW NE

FARM *E. E. Thiele* NO. 1

COUNTY *Norton*

TOTAL DEPTH *3775'*
COMM. *8-4-61* COMP. *8-13-61*
SHOT OR TREATED
CONTRACTOR *National Drilling Company, Inc.*
ISSUED

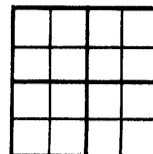

CASING

20	10	
15	8	-5/8 338'/240 sxs cement
12	6	14 sxs HA5
13	5	

ELEVATION 2469

PRODUCTION

FIGURES INDICATE BOTTOM OF FORMATIONS

<i>Clay & Shale</i>	75
<i>Sand</i>	85
<i>Sand</i>	210
XXX	
<i>Blue Shale</i>	327
<i>Shale</i>	600
<i>Shale</i>	1190
<i>Sand</i>	1265
<i>Shale & Shells</i>	1790
<i>Shale & Shells</i>	1995
<i>Anhydrite</i>	2035
<i>Shale & Shells</i>	2110
<i>Shale</i>	2515
<i>Lime & Shale</i>	2660
<i>Lime</i>	2850
<i>Lime</i>	2935
<i>Lime</i>	3045
<i>Lime</i>	3135
<i>Lime</i>	3190
<i>Lime</i>	3355
<i>Lime</i>	3475
<i>Lime</i>	3490
<i>Lime</i>	3500
<i>Lime</i>	3527
<i>Lime</i>	3555
<i>Lime</i>	3615
<i>Lime</i>	3635
<i>Lime</i>	3705
<i>Lime & Granit wash</i>	3758
<i>Lime & Granit wash</i>	3775

RECEIVED
STATE CORPORATION COMMISSION

AUG 21 1961
8-21-61
CONSERVATION DIVISION
Wichita, Kansas

I hereby certify that this is a true and correct log of the above described well as shown by the drilling reports.

NATIONAL DRILLING COMPANY, INC.

Howard A. Stoskopf
Howard A. Stoskopf

STATE OF KANSAS)
SEDGWICK COUNTY)

Subscribed and sworn to before me, a Notary Public, in and for said County and State this 16th day of August, 1961.

Dorothy L. Kimball
Notary Public/Dorothy L. Kimball

My Commission Expires: May 31, 1965.