

This form shall be filed in duplicate with the Kansas Corporation Commission, 200 Colorado Derby Building, Wichita, Kansas 67202, within ten days after the completion of the well, regardless of how the well was completed.

Attach separate letter of request if the information is to be held confidential. If confidential, only file one copy. Information on side one will be of public record and side two will then be held confidential.

Circle one: Oil, Gas, Dry, SWD, OWWO, Injection. Type and complete ALL sections. Applications must be filed for dual completion, commingling, SWD and injection, T.A.

Attach wireline logs (i.e. electrical log, sonic log, gamma ray neutron log, etc.). KCC # (316) 263-3238. (Rules 82-2-105 & 82-2-125)

OPERATOR Petro-Mining Resources, Inc.

API NO. 15-039-20,647-00-00

ADDRESS P.O. Drawer 298

COUNTY Decatur

Oberlin, Kansas 67749

FIELD

\*\*CONTACT PERSON James R. Betts

PROD. FORMATION D & A

PHONE 913-475-3801

LEASE Schwab

PURCHASER

WELL NO. 1-5

ADDRESS

WELL LOCATION C/NW NW SW/4

DRILLING Circle M Drilling

330 Ft. from North Line and

CONTRACTOR


330 Ft. from West Line of

ADDRESS P.O. Box 128

the SW/4 SEC. 5 TWP. 2-S RGE. 26-W

Oberlin, KS 67749

WELL PLAT

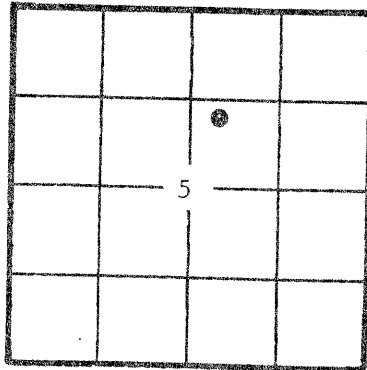

KCC [checked]
KGS [checked]
(Office Use)

PLUGGING Rocky Mt. Well Service Company

CONTRACTOR

ADDRESS P.O. Box 1066

Fort Morgan, CO 80702

TOTAL DEPTH 3745 PBDT 3731

SPUD DATE 4-13-82 DATE COMPLETED 4-22-82

ELEV: GR 2611 DF KB 2616

DRILLED WITH (CABLE) (ROTARY) (AIR) TOOLS

Amount of surface pipe set and cemented 8 5/8 x 219 . DV Tool Used? yes

AFFIDAVIT

STATE OF Kansas, COUNTY OF Decatur SS, I,

James R. Betts OF LAWFUL AGE, BEING FIRST DULY SWORN UPON HIS OATH, DEPOSES THAT HE IS President (FOR)(OF) Petro-Mining Resources, Inc.

OPERATOR OF THE Schwab LEASE, AND IS DULY AUTHORIZED TO MAKE

THIS AFFIDAVIT FOR AND ON THE BEHALF OF SAID OPERATOR, THAT WELL NO. 1-5 ON

SAID LEASE HAS BEEN COMPLETED AS OF THE 11th DAY OF May, 19 82, AND THAT

ALL INFORMATION ENTERED HEREIN WITH RESPECT TO SAID WELL IS TRUE AND CORRECT.


FURTHER AFFIANT SAITH NOT.

RECEIVED STATE CORPORATION COMMISSION

13 1982

CONSERVATION DIVISION Wichita Kansas

SUBSCRIBED AND SWORN BEFORE ME THIS 12th DAY OF May, 1982

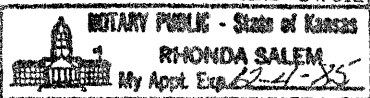

Handwritten signature of Rhonda Salem

NOTARY PUBLIC

5-13-82

\*\*The person who can be reached by phone regarding any questions concerning this information. Within 45 days of completion, a witnessed initial test by the Commission is required if the well produces more than 25 BOPD or is located in a Basic Order Pool.