

15-039-00034-00-00

STATE OF KANSAS
STATE CORPORATION COMMISSION


WELL PLUGGING RECORD

Give All Information Completely
Make Required Affidavit
Mail or Deliver Report to:
Conservation Division
State Corporation Commission
800 Bitting Building
Wichita, Kansas

OR
FORMATION PLUGGING RECORD

Strike out upper line
when reporting plug-
ging off formations.

County. Sec. 5 Twp. 2S Rge. 26 (E) W (W)
Location as "NE $\frac{1}{4}$ NW $\frac{1}{4}$ SW $\frac{1}{4}$ " or footage from lines. SE $\frac{1}{4}$ SE $\frac{1}{4}$ NE $\frac{1}{4}$
Lease Owner J. M. Huber Corporation
Lease Name Railsback Well No. 1
Office Address 302 Petroleum Building, Wichita, Kansas
Character of Well (completed as Oil, Gas or Dry Hole) Dry Hole
Date well completed 4-3-19 52
Application for plugging filed 4-3-19 52
Application for plugging approved 4-3-19 52
Plugging commenced 4-3-19 52
Plugging completed 4-3-19 52
Reason for abandonment of well or producing formation.....

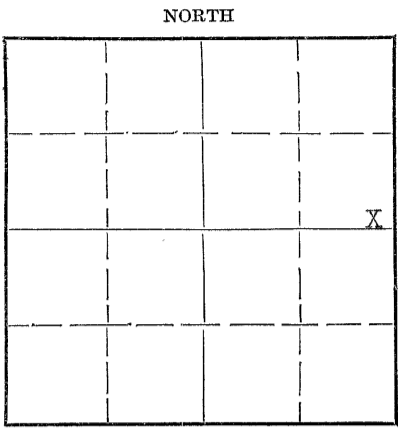

Locate well correctly on above
Section Plat

If a producing well is abandoned, date of last production..... 19.....
Was permission obtained from the Conservation Division or its agents before plugging was com-
menced? Yes

Name of Conservation Agent who supervised plugging of this well Eldon Petty, Hays, Kansas
Producing formation..... Depth to top..... Bottom..... Total Depth of Well..... Feet
Show depth and thickness of all water, oil and gas formations.

OIL, GAS OR WATER RECORDS

CASING RECORD

Formation	Content	From	To	Size	Put In	Pulled Out
				8-5/8 "	95'	None

Describe in detail the manner in which the well was plugged, indicating where the mud fluid was placed and the method or methods used in introducing it into the hole. If cement or other plugs were used, state the character of same and depth placed, from.....feet to
.....feet for each plug set.

Filled hole with heavy drilling mud to 90', set plug and cemented with 15 sacks cement. Filled hole to 40' with heavy drilling mud, set plug and cemented to bottom of cellar with 10 sacks cement.

APR 16 1952

4-16-52

(If additional description is necessary, use BACK of this sheet)

Correspondence regarding this well should be addressed to..... J. M. Huber Corporation
Address..... 302 Petroleum Building
Wichita 2, Kansas

STATE OF Kansas, COUNTY OF Sedgwick, ss.
J. W. Owen (employee of owner) or (owner or operator)


being first duly sworn on oath, says: That I have knowledge of the facts, statements, and matters herein contained and the log of the above-described well as filed and that the same are true and correct. So help me God.

(Signature) J. W. Owen
302 Petroleum Building
Wichita, Kansas (Address)

SUBSCRIBED AND SWORN to before me this 14th day of April, 1952.

My commission expires January 26, 1953

Dorothy J. Benez
Notary Public.

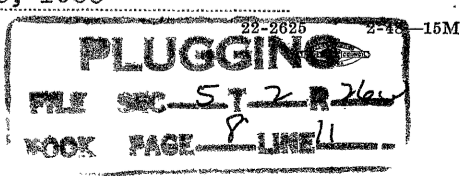

15-039-00034-00-00

J. M. HUBER CORPORATION

SE/4 SE/4 NE/4
Sec. 5-2S-26W
Decatur County,
Kansas

RAILSBACK # 1 WELL

<u>FORMATION</u>	<u>FROM</u>	<u>TO</u>	<u>REMARKS</u>
Surface Sand & Clay	0	96	8-5/8" C.S.A. Cemented with 75 Sacks Cement. Set @ 95'
Sand	96	160	
Rock & Clay	160	210	
Shale & Shell	210	860	
Shale Shell & Pyrite	860	980	
Shale & Shell	980	1180	
Sand Shale & Pyrite	1180	1550	
Shale Shells & Pyrite	1550	1720	
Shale & Sand	1720	1815	
Shale Red Bed Shell	1815	1950	
Shale Shells & Red Bed	1950	2035	
Anhydrite	2035	2075	
Shale & Shells	2075	2470	
Shale & Lime	2470	3125	
Lime & Shale	3125	3200	
Lime	3200	3545	
Lime & Shale	3545	3790	
Total Depth		3790'	

I hereby certify the foregoing to be a true and accurate Driller's Log of the formations encountered in the above well.

J. M. HUBER CORPORATION

By: J. W. Owen
J. W. Owen
Geologist

Subscribed and sworn to before me this 14th day of April, 1952.

Sarah J. Breen
Notary Public

My commission expires:

January 26, 1953

