

TYPE

AFFIDAVIT OF COMPLETION FORM

ACO-1 WELL HISTORY

Compt. _____

SIDE ONE

Two (2) copies of this form shall be filed with the Kansas Corporation Commission, 200 Colorado Derby Building, Wichita, Kansas 67202, within thirty (30) days after the completion of a well, regardless of how the well was completed.

(F) Attach separate letter of request if the information is to be held confidential. If confidential, only file one copy. Information on Side One will be of public record and Side Two will then be held confidential.

Applications must be made on dual completion, commingling, salt water disposal, injection and temporarily abandoned wells.

(C) Attach one copy only wireline logs (i.e. electrical log, sonic log, gamma ray neutron log, etc.). (Rules 82-2-105 & 82-2-125) KCC# (316) 263-3238.

LICENSE # 8684 EXPIRATION DATE 06/84

OPERATOR Houston Hydrolance International, Inc. API NO. 15-039-20695 00 00

ADDRESS P. O. Box 3723 COUNTY Decatur

Victoria, Texas 77903 FIELD Wildcat MONAGHAN NO.

** CONTACT PERSON Melvin Klotzman PROD. FORMATION Lansing

PHONE 1-800-539-3640

PURCHASER Inland Crude Purchasing Corporation LEASE Macfee

ADDRESS 200 Douglas Building WELL NO. 2

Wichita, Kansas 67202 WELL LOCATION SE NW SE

DRILLING CONTRACTOR Stooppelwerth Drilling, Inc. 1550 Ft. from S Line and

ADDRESS 111 East H 1550 Ft. from E Line of


McCook, Nebraska 69001 the (Qtr.) SEC 3 TWP 28 RGE 27W.

PLUGGING CONTRACTOR _____

ADDRESS _____

WELL PLAT

(Office Use Only)

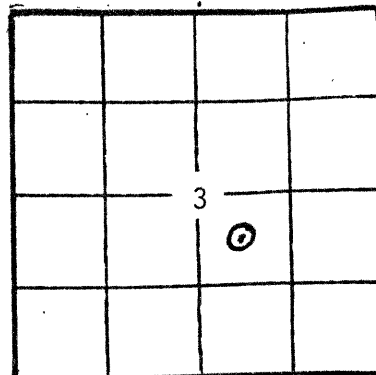

KCC

KGS

SWD/REP _____

PLG. _____

TOTAL DEPTH 3855 PBD 3814

SPUD DATE 08/01/83 DATE COMPLETED 08/17/83

ELEV: GR 2605 DF _____ KB 2610

DRILLED WITH ~~(CABLE)~~ (ROTARY) ~~(AIR)~~ TOOLS.

DOCKET NO. OF DISPOSAL OR REPRESSURING WELL BEING USED TO DISPOSE OF WATER FROM THIS LEASE _____

Amount of surface pipe set and cemented 258 DV Tool Used? No

THIS AFFIDAVIT APPLIES TO: (Circle ONE) - Oil Gas, Shut-in Gas, Dry, Disposal, Injection, Temporarily Abandoned, OWWO. Other _____

ALL REQUIREMENTS OF THE STATUTES, RULES AND REGULATIONS PROMULGATED TO REGULATE THE OIL AND GAS INDUSTRY HAVE BEEN FULLY COMPLIED WITH.

A F F I D A V I T

MELVIN KLOTZMAN

, being of lawful age, hereby certifies that:

I am the Affiant, and I am familiar with the contents of the foregoing Affidavit. The statements and allegations contained therein are true and correct.

Melvin Klotzman (Name) Petroleum Consultant

SUBSCRIBED AND SWORN TO BEFORE ME this 29th day of AUGUST, 1983.

MY COMMISSION EXPIRES: 2/06/85

STATE OF KANSAS RECEIVED [Signature] (Notary Public)

SEP 2 1983 CONSERVATION COMMISSION Wichita, Kansas

** The person who can be reached by phone regarding any questions concerning this information.

9-2-83