

15-039-20021-00-00 BR


STATE OF KANSAS
STATE CORPORATION COMMISSION

Form CP-4

Give All Information Completely
Make Required Affidavit
Mail or Deliver Report to:
Conservation Division
State Corporation Commission
211 No. Broadway
Wichita, Kansas

WELL PLUGGING RECORD

Decatur County, Sec. 30 Twp. 2 Rge. 26W (E) (W)

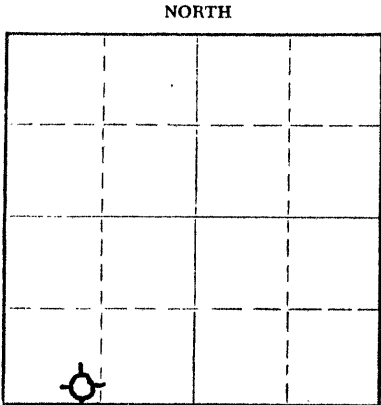

Locate well correctly on above
Section Plat

Location as "NE/CNW/SW" or footage from lines SW SW SE
Lease Owner Donald C. Slawson
Lease Name Ohms 'A' Well No. 1
Office Address 408 One Twenty Bldg-Wichita, Kansas
Character of Well (completed as Oil, Gas or Dry Hole) Dry Hole
Date well completed August 13, 1967
Application for plugging filed August 13, 1967
Application for plugging approved August 13, 1967
Plugging commenced August 13, 1967
Plugging completed August 13, 1967
Reason for abandonment of well or producing formation Dry Hole

If a producing well is abandoned, date of last production 19
Was permission obtained from the Conservation Division or its agents before plugging was commenced? Yes

Name of Conservation Agent who supervised plugging of this well W.L. Nichols-P.O. Box 157-Morland, Kansas
Producing formation _____ Depth to top _____ Bottom _____ Total Depth of Well 2365 Feet
Show depth and thickness of all water, oil and gas formations.

OIL, GAS OR WATER RECORDS

FORMATION	CONTENT	FROM	TO	SIZE	PUT IN	PULLED OUT

RECEIVED
AUG 22 1967
CONSERVATION DIVISION
Wichita, Kansas
8-22-67

Describe in detail the manner in which the well was plugged, indicating where the mud fluid was placed and the method or methods used in introducing it into the hole. If cement or other plugs were used, state the character of same and depth placed, from _____ feet to _____ feet for each plug set.

Mud to 1320'; cemented with 105 sx cement
Mud to 280'; set plug; 25 sx cement
Mud to 40'; set plug; 10 sx cement
2 sx cement in rat hole.

(If additional description is necessary, use BACK of this sheet)
Name of Plugging Contractor Slawson Drilling Company, Inc.
Address Suite 408 One Twenty Building - Wichita, Kansas 67202

STATE OF KANSAS, COUNTY OF SEDGWICK, ss.

DONALD C. SLAWSON (employee of owner) or (owner or operator) of the above-described well, being first duly sworn on oath, says: That I have knowledge of the facts, statements, and matters herein contained and the log of the above-described well as filed and that the same are true and correct. So help me God.

(Signature) [Signature]
408 One Twenty Bldg-Wichita, Kansas
(Address)

SUBSCRIBED AND SWORN to before me this 19th day of August, 1967

My commission expires May 15, 1971
Linda R. Sparr
Linda R. Sparr Notary Public.

WELL LOG

Company: Donald C. Slawson
 408 One Twenty Building
 Wichita, Kansas 67202

Farm: Ohms 'A' #1
 SW SW SE, Section 30-2-26W
 Decatur County, Kansas

Total Depth: 2365' Elevation: 2650 K.B.

Contractor: Slawson Drilling Company, Inc.

Commenced: August 11, 1967

Completed: August 13, 1967

Casing: 8 5/8" at 260' with 175 sx cement

0-55	Surface Clay
55-105	Shale
105-1203	Shale & Shells
1203-1290	Sand
1290-1400	Shale & Sand
1400-2178	Shale & Shells
2178-2210	Anhydrite
2210-2365	Shale & Shells
2365	Total Depth

RECEIVED
 ST. REGULATION COMMISSION
 AUG 22 1967
 8-22-67
 CONSERVATION DIVISION

STATE OF KANSAS)
) SS:
 COUNTY OF SEDGWICK)

I, Donald C. Slawson, of the Slawson Drilling Company, Inc., upon oath state that the above and foregoing is a true and correct copy of the log of the Ohms 'A' #1 well.


 DONALD C. SLAWSON

Subscribed and sworn to before me this 19th day of August, 1967.


 Linda R. Sparr, Notary Public

My Commission Expires:
 May 15, 1971