

15-039-20132-00-00


STATE OF KANSAS
STATE CORPORATION COMMISSION

Form CP-4

WELL PLUGGING RECORD

Give All Information Completely
Make Required Affidavit
Mail or Deliver Report to:
Conservation Division
State Corporation Commission
211 No. Broadway
Wichita, Kansas

Decatur County. Sec. 12 Twp. 2S Rge. 27 (X) W (W)
Location as "NE/CNW%SW%" or footage from lines c/SW/4 SW/4
Lease Owner Stoepelwerth Drilling, Inc.
Lease Name Herbert Shirley Well No. 1
Office Address Box 193, Russell, Kansas 67665
Character of Well (completed as Oil, Gas or Dry Hole) Dry Hole
Date well completed 12/10/69 19
Application for plugging filed 12/10/69 by phone 19
Application for plugging approved 12/10/69 by phone 19
Plugging commenced 12/10/69 19
Plugging completed 12/10/69 19
Reason for abandonment of well or producing formation Dry Hole

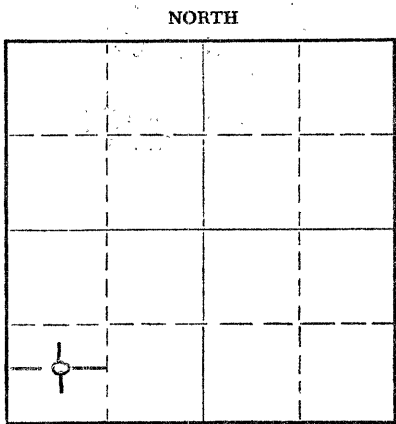

Locate well correctly on above
Section Plat

If a producing well is abandoned, date of last production _____ 19____
Was permission obtained from the Conservation Division or its agents before plugging was commenced? yes

Name of Conservation Agent who supervised plugging of this well Bill Nichols
Producing formation None Depth to top _____ Bottom _____ Total Depth of Well 3931 Feet
Show depth and thickness of all water, oil and gas formations.

OIL, GAS OR WATER RECORDS

CASING RECORD

| FORMATION | CONTENT | FROM | TO | SIZE | PUT IN | PULLED OUT |
|-----------|---------|------|------|-------|--------|------------|
| Surface | Water | 0 | 230* | 8 5/8 | 259* | 0 |
| | | | | | | |
| | | | | | | |
Describe in detail the manner in which the well was plugged, indicating where the mud fluid was placed and the method or methods used in introducing it into the hole. If cement or other plugs were used, state the character of same and depth placed, from _____ feet to _____ feet for each plug set.

Circulated hole from bottom, laid down drill pipe to 1325*, Circulated and pumped 100 cubic feet 60-40 pozmix, laid down to 275*, circulated, pumped 25 cubic feet 60-40 pozmix, laid down to 40*, circulated, pumped 10 cubic feet 60-40 pozmix

RECEIVED
STATE CORPORATION COMMISSION
JAN 6 1970
CONSERVATION DIVISION
Wichita, Kansas

1-6-70

(If additional description is necessary, use BACK of this sheet)


Name of Plugging Contractor Halliburton Services
Address Hays, Kansas

STATE OF Kansas, COUNTY OF Russell, ss.
George P Stoepelwerth II (employee of owner) or (owner or operator) of the above-described well, being first duly sworn on oath, says: That I have knowledge of the facts, statements, and matters herein contained and the log of the above-described well as filed and that the same are true and correct. So help me God.

(Signature) George P Stoepelwerth II

(Address) _____

SUBSCRIBED AND SWORN to before me this 29th day of December, 19 69
My commission expires April 9, 1972

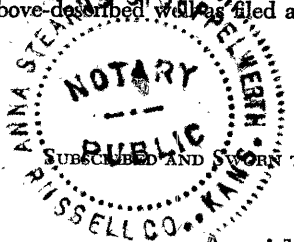

Anna Stearns Stoepelwerth
Notary Public.

15-039-20132-00-00

DRILLERS LOG

STOEPPELWERTH DRILLING, INC.
RUSSELL, KANSAS

Well #1 Shirley Commenced drilling Nov. 30, 1969
Location SW SW 12-2S-27W Completed drilling Dec. 10, 1969
Decatur Co., Kansas
Surface casing 8 5/8" @ 259' w/ 165sx 50-50 pozmix

Formation Record:

| Footage | Formation |
|-----------|--|
| 0 - 240 | Surface sand and clay |
| 240 -1300 | Shale |
| 1300-2142 | Sand and shale |
| 2142-2174 | Anhydrite |
| 2174-2895 | Sand and shale with streaks of limestone |
| 2895-3320 | Lime and shale with streaks of sand |
| 3320-3820 | Lime and shale |
| 3820-3920 | Sand and shale |
| 3920-TD | Granite wash and granite |
| 3931 TD | |

RECEIVED
STATE CORPORATION COMMISSION
FEB 4 1970
CONSERVATION DIVISION
Wichita, Kansas
2-4-70

Drilling Time (Min. per 2 ft.) (Continued on reverse side)

| | | | | | | | | | | | | | | | | | | | | | | | | | |
|---------|----|----|----|----|----|----|----|----|---|----|----|----|----|----|----|----|----|----|----|----|----|----|----|---|----|
| 3100-50 | 8 | 8 | 9 | 7 | 8 | 13 | 12 | 8 | 9 | 7 | 8 | 7 | 7 | 12 | 8 | 8 | 5 | 3 | 8 | 9 | 6 | 9 | 10 | 8 | 9 |
| 3150-00 | 8 | 10 | 9 | 8 | 19 | 7 | 7 | 8 | 8 | 9 | 10 | 10 | 11 | 13 | 8 | 7 | 10 | 5 | 8 | 6 | 10 | 11 | 9 | 7 | 6 |
| 3200-50 | 11 | 13 | 13 | 12 | 6 | 5 | 5 | 5 | 6 | 7 | 10 | 12 | 12 | 8 | 6 | 7 | 6 | 6 | 6 | 6 | 4 | 5 | 5 | 4 | 3 |
| 3250-00 | 5 | 2 | 7 | 12 | 13 | 9 | 8 | 11 | 9 | 13 | 11 | 8 | 6 | 7 | 6 | 7 | 6 | 6 | 6 | 8 | 8 | 8 | 5 | 5 | 11 |
| 3300-50 | 10 | 9 | 5 | 5 | 7 | 2 | 3 | 4 | 3 | 4 | 6 | 7 | 8 | 5 | 5 | 6 | 7 | 6 | 5 | 5 | 6 | 5 | 5 | 5 | 6 |
| 3350-00 | 5 | 5 | 5 | 5 | 6 | 6 | 7 | 6 | 5 | 7 | 7 | 6 | 6 | 6 | 7 | 7 | 4 | 6 | 3 | 3 | 5 | 6 | 6 | 7 | 6 |
| 3400-50 | 5 | 6 | 8 | 6 | 6 | 6 | 5 | 6 | 5 | 6 | 5 | 5 | 6 | 8 | 6 | 7 | 4 | 7 | 7 | 7 | 9 | 6 | 7 | 6 | 7 |
| 3450-00 | 5 | 7 | 6 | 3 | 4 | 6 | 6 | 7 | 6 | 4 | 6 | 8 | 7 | 9 | 7 | 7 | 7 | 9 | 8 | 9 | 8 | 7 | 8 | 9 | 8 |
| 3500-50 | 14 | 11 | 12 | 11 | 9 | 7 | 7 | 10 | 9 | 8 | 8 | 9 | 10 | 11 | 11 | 11 | 12 | 10 | 11 | 20 | 4 | 7 | 8 | 8 | 7 |
| 3550-00 | 3 | 3 | 2 | 3 | 3 | 4 | 6 | 4 | 5 | 4 | 5 | 6 | 7 | 7 | 5 | 6 | 7 | 5 | 6 | 4 | 3 | 5 | 6 | 5 | 5 |
| 3600-50 | 6 | 7 | 7 | 6 | 7 | 7 | 6 | 7 | 5 | 5 | 5 | 5 | 3 | 3 | 5 | 5 | 4 | 5 | 5 | 6 | 7 | 6 | 7 | 7 | 6 |

I hereby certify that the above and foregoing is a true and accurate report of the drilling of the well described.

Date: February 2, 1970

G.P. Stoeppelwerth
G.P. Stoeppelwerth, II

State of _____

County of _____

Subscribed and sworn before me, a Notary Public, this _____ day of _____

My commission expires _____

