


Give All Information Completely  
Make Required Affidavit  
Mail or Deliver Report to:  
Conservation Division  
State Corporation Commission  
800 Bitting Building  
Wichita, Kansas

15-039-00490-00-00

WELL PLUGGING RECORD

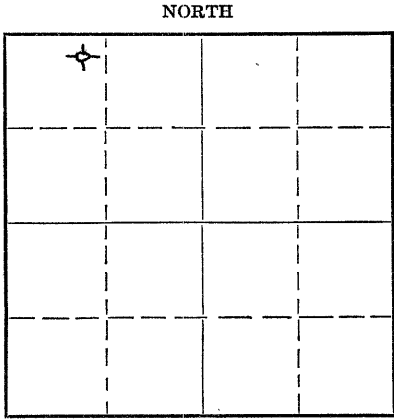

Locate well correctly on above Section Plat

DECATUR County. Sec. 22 Twp. 2 Rge. 27 ~~W~~ W (W)  
Location as "NE/CNW 1/4 SW 1/4" or footage from lines NE NW NW  
Lease Owner THE HENDERSON OIL COMPANY et al  
Lease Name MONAGHAN Well No. 1  
Office Address 502 Orpheum Bldg., Wichita, Kansas  
Character of Well (completed as Oil, Gas or Dry Hole) DRY  
Date well completed August 7th 19 54  
Application for plugging filed August 7th 19 54  
Application for plugging approved August 7th 19 54  
Plugging commenced August 7th 19 54  
Plugging completed August 7th 19 54  
Reason for abandonment of well or producing formation DRY

If a producing well is abandoned, date of last production 19  
Was permission obtained from the Conservation Division or its agents before plugging was commenced? Yes

Name of Conservation Agent who supervised plugging of this well ELDON PETTY  
Producing formation Lans. K.C. Depth to top 3500 Bottom 3705 Total Depth of Well 3710 Feet  
Show depth and thickness of all water, oil and gas formations.

OIL, GAS OR WATER RECORDS

CASING RECORD

Formation	Content	From	To	Size	Put In	Pulled Out
				8 5/8	448'	None

Describe in detail the manner in which the well was plugged, indicating where the mud fluid was placed and the method or methods used in introducing it into the hole. If cement or other plugs were used, state the character of same and depth placed, from feet to feet for each plug set.

Hole filled with heavy mud to 300 feet.  
Ran plug and one-half sack hulls to 300 feet.  
Cemented with fifteen sacks cement.  
Filled hole with heavy mud to 40 feet.  
Ran plug and one-half sack hulls to 40 feet.  
Cemented with ten sacks cement.  
Filled to surface with soil.

RECEIVED  
STATE CORPORATION COMMISSION  
AUG 13 1954  
CONSERVATION DIVISION  
Wichita, Kansas  
8-13-54

(If additional description is necessary, use BACK of this sheet)  
Name of Plugging Contractor BILL HAY DRILLING COMPANY  
Address Hoisington, Kansas

STATE OF KANSAS, COUNTY OF SEDGWICK, ss.  
J. A. HENDERSON (employee of owner) or (owner or operator) of the above-described well,  
being first duly sworn on oath, says: That I have knowledge of the facts, statements, and matters herein contained and the log of the above-described well as filed and that the same are true and correct. So help me God.

(Signature) J. A. Henderson  
502 Orpheum Building, Wichita, Kansas (Address)

SUBSCRIBED AND SWORN to before me this 10th day of August, 1954  
Notary Public

My commission expires April 28, 1958

PLUGGING  
FILE SEC 22 T 2 R 22W  
BOOK PAGE 56 LINE 20  
6-51-20M

WELL LOG

The Henderson Oil Company et al - owners - Monaghan #1  
 NE NW NW  
 Section 22-2-27W  
 Decatur County, Kansas  
 D & A

Elevation 2613 R.B.

Tops at Rotary Bushing

Heebner 3467  
 Lansing 3500  
 Base K. C. 3705

Figures indicate bottom of formation

0 - 6 Soil  
 440 Sand  
 1190 Shale and shells  
 1355 Sand  
 1455 Shale and shells  
 1560 Shale  
 2160 Shale and shells  
 2192 Anhydrite  
 2300 Shale and shells  
 2445 Anhydrite streaks  
 2697 Shale and shells  
 3110 Lime and shale  
 3190 Shale  
 3500 Lime and shale  
 3705 Lime  
 3710 Shale  
 3710 R.T.D.

Pipe Record:

8 5/8" set at 448'

Rotary Commenced July 28th, 1954  
 Rotary Completed August 7th, 1954

D.S.T. #1 3514-38; Opn 1 hr  
 recovered 25' OCM, 0# BH. P.  
 D.S.T.#2 3541-76; Opn 1 hr.  
 recovered 2' oil, 16' OCM, 30' mud  
 0# FFP, 740# B.H.P.

RECEIVED  
 STATE CORPORATION COMMISSION  
 AUG 13 1954  
 CONSERVATION DIVISION  
 White, Kansas

STATE OF KANSAS  
 COUNTY OF SEDGWICK

8-13-54

I, J. A. Henderson, President of The Henderson Oil Company, part owner of the above described well, being first duly sworn on oath, declare: That I have knowledge of the facts, statements, and matters herein contained pertaining to the log of the above described well, and that the same are true and correct.

J. A. Henderson

Sworn and subscribed to before me this 10th day of August 1954.

Ina Swanson  
 NOTARY PUBLIC

My commission expires April 28, 1958.

**PLUGGING**  
 FILE SEC 22 T 2 R 27W  
 BOOK PAGE 56 LINE 20