


15-039-00513-00-00

WELL PLUGGING RECORD

Give All Information Completely  
Make Required Affidavit  
Mail or Deliver Report to:  
Conservation Division  
State Corporation Commission  
800 Bitting Building  
Wichita, Kansas

Decatur County. Sec. 21 Twp. 2S Rge. 27 (E) (W)

Location as "NE/CNW/SW" or footage from lines NE NE NE  
Lease Owner H. E. Zoller et al  
Lease Name Edwards Well No. 1  
Office Address 409 California Bldg., Denver 2, Colorado  
Character of Well (completed as Oil, Gas or Dry Hole) Dry Hole  
Date well completed December 28, 1953  
Application for plugging filed December 28, (verbal) 1953  
Application for plugging approved December 28, (verbal) 1953  
Plugging commenced December 28, 1953  
Plugging completed December 28, 1953  
Reason for abandonment of well or producing formation \_\_\_\_\_

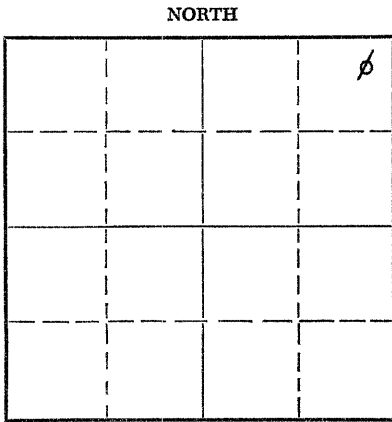

Locate well correctly on above Section Plat

If a producing well is abandoned, date of last production none 19\_\_\_\_  
Was permission obtained from the Conservation Division or its agents before plugging was commenced? Yes

Name of Conservation Agent who supervised plugging of this well Eldon Petty  
Producing formation none Depth to top \_\_\_\_\_ Bottom \_\_\_\_\_ Total Depth of Well 4025 Feet  
Show depth and thickness of all water, oil and gas formations.

OIL, GAS OR WATER RECORDS

CASING RECORD

FORMATION	CONTENT	FROM	TO	SIZE	PUT IN	PULLED OUT
				8 5/8"	242.9	none

Describe in detail the manner in which the well was plugged, indicating where the mud fluid was placed and the method or methods used in introducing it into the hole. If cement or other plugs were used, state the character of same and depth placed, from \_\_\_\_\_ feet to \_\_\_\_\_ feet for each plug set.

Circulated hole with heavy mud. Set cementing plug at 230 feet with 1/2 sack of hulls and 15 sacks cement; Mud to 40 feet, Set cementing plug, 1/2 sack hulls and 10 sx cement to bottom of cellar.

(If additional description is necessary, use BACK of this sheet)

Name of Plugging Contractor Mallonee Drilling Company, Inc.,  
Address 812 Central Bldg., Wichita, Kansas

STATE OF Colorado COUNTY OF Denver, ss.  
Arthur M. Scott (employee of owner) or (~~owner or operator~~) of the above-described well, being first duly sworn on oath, says: That I have knowledge of the facts, statements, and matters herein contained and the log of the above-described well as filed and that the same are true and correct. So help me God.

(Signature) Arthur M. Scott  
409 California Bldg., Denver 2, Colo.  
(Address)

SUBSCRIBED AND SWORN TO before me this 11th day of March, 1954  
Carol Lee Frasier  
Notary Public.

My commission expires November 10, 1957

24-7368-S 3-53-20M

PLUGGING  
NOV 21 2 27W  
NOV 5 1953

3-12-54


15-039-00513-00-00

DRILLER'S LOG  
#1 EDWARDS  
NE NE NE SEC. 21-2S-27W  
DECATUR COUNTY, KANSAS

OWNER: H. E. Zoller & E. K. Carey Drilling Co.  
CONTRACTOR: Mallonee Drilling Company, Inc.

COMMENCED: 12-15-53  
COMPLETED: 12-28-53  
ELEV.: 2643 K. B.

<u>FROM</u>	<u>TO</u>	<u>DESCRIPTION</u>	<u>REMARKS</u>
0 -	45	Shale	
45 -	185	Shale and Sand	
185 -	215	Sand	
215 -	240	Shale	
			242.9' 8-5/8 casing set at 240' w/150 sks and 1 c.c.
240 -	540	Shale and shells	
540 -	1200	Shale and Sand	
1200 -	1890	Shale and Shells	
1890 -	1960	Sand and shale	
1960 -	2181	Shale and red bed	
2181 -	2219	Anhydrite	
2219 -	2620	Shale and shells	
2620 -	3385	Lime and shale	
3385 -	3725	Lime	
3725 -	4025	Lime and Shale	
	4025	Total Depth of hole	

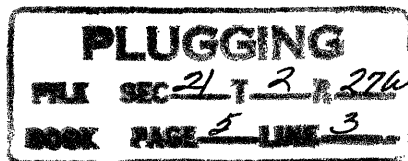

I certify that to the best of my knowledge and belief, the above represents a true and accurate Driller's Log record of the above-captioned well.

/s/ R. E. Mallonee

Subscribed and sworn to before me this 30th day of December, 1953.

(SEAL)

/s/ Rosemary Penrose  
Notary Public

My commission expires:  
March 30, 1957

MAR 10 1954  
3-10-54  
CONSERVATION DIVISION  
WICK

I certify that this a true copy of the Driller's Log as furnished to us.

Subscribed and sworn to before me this 5th day of March, 1954.

*Arthur M. Scott*

STATE OF COLORADO )  
COUNTY OF DENVER )ss.

Carol Lee Frasier  
Notary Public

My Commission expires November 10, 1957.