


STATE OF KANSAS
STATE CORPORATION COMMISSION

15-039-00179-00-00

Give All Information Completely
Make Required Affidavit
Mail or Deliver Report to:
Conservation Division
State Corporation Commission
217 No. Broadway
Wichita, Kansas

WELL PLUGGING RECORD

NORTH

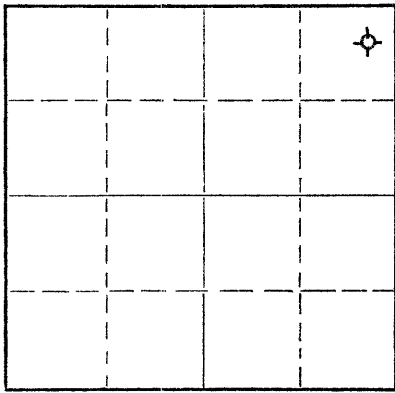

Locate well correctly on above
Section Plat

Decatur County. Sec. 16 Twp. 2 Rge. 27 (E) W (W)
Location as "NE/CNW/SW" or footage from lines NE NE NE
Lease Owner H.E. Zoller & E.K. Carey Drilling Co., Inc.
Lease Name Monaghan "A" Well No. 1
Office Address 818 Central Building, Wichita, Kansas
Character of Well (completed as Oil, Gas or Dry Hole) Dry Hole
Date well completed December 29 19 56
Application for plugging filed December 29 19 56
Application for plugging approved December 29 19 56
Plugging commenced December 29 19 56
Plugging completed December 29 19 56
Reason for abandonment of well or producing formation Too low structurally

If a producing well is abandoned, date of last production _____ 19____
Was permission obtained from the Conservation Division or its agents before plugging was commenced? Yes

Name of Conservation Agent who supervised plugging of this well Eldon Petty, Hays, Kansas
Producing formation _____ Depth to top _____ Bottom _____ Total Depth of Well 3620 Feet
Show depth and thickness of all water, oil and gas formations.

OIL, GAS OR WATER RECORDS

CASING RECORD

FORMATION	CONTENT	FROM	TO	SIZE	PUT IN	PULLED OUT
				8-5/8"	225'	none

Describe in detail the manner in which the well was plugged, indicating where the mud fluid was placed and the method or methods used in introducing it into the hole. If cement or other plugs were used, state the character of same and depth placed, from _____ feet to _____ feet for each plug set.

filled hole with heavy mud to 220'. Set plug. Put in 15 sacks of cement and 1/2 sack Hulls. Filled with heavy mud up to 40. Set plug. Filled to top with 10 sacks cement & 1/2 sack Hulls.

(If additional description is necessary, use BACK of this sheet)

Name of Plugging Contractor C-G Drilling Co.
Address 107 Rule Building, Wichita, Kansas


STATE OF KANSAS, COUNTY OF SEDGWICK, ss.
G. F. Galloway (employee of owner) or (owner or operator) of the above-described well, being first duly sworn on oath, says: That I have knowledge of the facts, statements, and matters herein contained and the log of the above-described well as filed and that the same are true and correct. So help me God.

(Signature) G. F. Galloway
107 Rule Building
(Address)

SUBSCRIBED AND SWORN to before me this 3rd day of January, 1957

My commission expires May 20, 1959

Vicky Jacobs
Vicky Jacobs Notary Public.

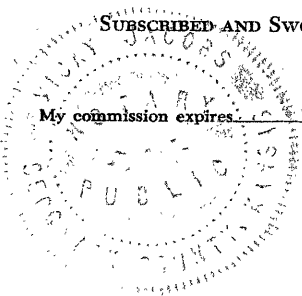

PLUGGING
FILE SEC 16 T. 2 R. 27W
BOOK PAGE 131 LINE 4

RECEIVED
STATE CORPORATION COMMISSION

JAN 4 X 1957 14-57

CONSERVATION DIVISION
Wichita, Kansas

15-039-00179-00-00

CONTRACTOR'S WELL LOG

OPERATOR H. E. Zoller & E. K. Carey Drilling Co., Inc. WELL NAME Monaghan "A" #1

LOCATION NE NE NE Sec. 16-2S-27W RIG NO. 1

COUNTY Decatur STATE Kansas

COMMENCEMENT DATE December 20, 1956 COMPLETION DATE December 29, 1956

LOG OF WELL

Elevation 2535' Rotary bushing.
All measurements taken from the top of rotary bushing.

FROM	TO	FORMATION	DEVIATION FROM VERTICAL	REMARKS
0	225	Surface Soil		
225	900	Shale		
900	1200	Sand		
1200	2066	Sand-Shale		
2066	2100	Anhydrite		
2100	2290	Lime-Shale		
2290	2550	Lime-Shale	0° - 2500	
2550	2775	Lime-Shale	0° - 2750	
2775	2990	Shale		
2990	3115	Lime-Shale	0° - 3000	
3115	3265	Lime-Shale		
3265	3353	Shale	0° - 3250	
3353	3415	Lime-Shale		
3415	3445	Lime-Shale		DST 3353-3415
3445	3510	Lime-Shale	0° - 3500	DST 3451-3445
3510	3620	Lime-Shale		

CASING LEFT IN HOLE AFTER COMPLETION

Set 225' (11 jts.) 8-5/8" OD Surface Casing

STATE OF KANSAS)
COUNTY OF SEDGWICK)) SS.

The undersigned hereby certifies that to the best of his knowledge and belief, the above facts are true and correct.

C-G DRILLING CO.

BY G. S. Zoller

Subscribed and sworn to before me this 2nd day of January, 1957.

My commission expires:
May 20, 1959

Vicky Jacobs
Vicky Jacobs, Notary Public

PLUGGING
FILE SEC. 16 T. 2 R. 27W
BOOK PAGE 131 LINE 4

RECEIVED
STATE CORPORATION COMMISSION
JAN 4 1957
CONSERVATION DIVISION
Wichita, Kansas
14-57