


STATE OF KANSAS
STATE CORPORATION COMMISSION

WELL PLUGGING RECORD

Give All Information Completely
Make Required Affidavit
Mail or Deliver Report to
Conservation Division
State Corporation Comm.
245 North Water
Wichita, KS 67202

Decatur County. Sec. 15 Twp. 2 Rge. 27W E/W
Location as "NE/CNW $\frac{1}{4}$ SW $\frac{1}{4}$ " or footage from lines
C NE SW

Lease Owner Baird Oil Co., Inc.
Lease Name Simpson #1 Well No. _____
Office Address Box 7, Logan, Ks. 67646
Character of Well (Completed as Oil, Gas or Dry Hole) _____

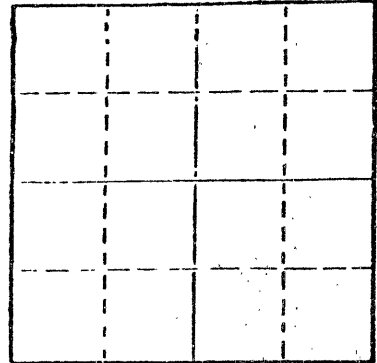

Locate well correctly on above
Section Plot

Date Well completed _____ 19____
Application for plugging filed _____ 19____
Application for plugging approved _____ 19____
Plugging commenced 12/4/80 _____ 19____
Plugging completed 12/11/80 _____ 19____
Reason for abandonment of well or producing formation _____
Depleted

If a producing well is abandoned, date of last production _____ 19____

Was permission obtained from the Conservation Division or its agents before plugging was commenced? Yes

Name of Conservation Agent who supervised plugging of this well Gil Balthazor
Producing formation _____ Depth to top _____ Bottom _____ Total Depth of Well 3720'
Show depth and thickness of all water, oil and gas formations.

OIL, GAS OR WATER RECORDS

CASING RECORD

FORMATION	CONTENT	FROM	TO	SIZE	PUT IN	PULLED OUT
				8-5/8"	216'	None
				4-1/2"	3719	1908

Describe in detail the manner in which the well was plugged, indicating where the mud fluid was placed and the method or methods used in introducing it into the hold. If cement or other plugs were used, state the character of same and depth placed, from _____ feet to _____ feet for each plug set.

~~XXXXXX~~
Pushed plug to 3480'. Ran sand to 3400' and 4 sacks cement. Shot and worked pipe at 2720, 2472, 2350, 2228, 2103 and 1970. ~~XXXXXX~~ Worked loose and pulled 46 joints. Plugged well and 3 sacks hulls, 70 sacks cement and 11 sacks gel. Released plug and pumped 60 sacks cement.
Plugging Complete.

(If additional description is necessary, use BACK of this sheet)

Name of Plugging Contractor KESLO CASING PULLING
CHASE, KANSAS

STATE OF Kansas COUNTY OF Rice
R. Darrell Kelso (employee of owner) or (owner) or operator
of the above-described well, being first duly sworn on oath, says: I have knowledge of the facts, statements, and matters herein contained and the log of the above described well as filed and that the same are true and correct. So help me God.

(Signature) R. Darrell Kelso 12-17-80
Chase, Kansas (Address)

SUBSCRIBED AND SWORN TO before me this 16th day of December, 19 80



My commission expires _____

Joan Kelso
Notary Public.

