


STATE OF KANSAS  
STATE CORPORATION COMMISSION

Give All Information Completely  
Make Required Affidavit  
Mail or Deliver Report to:  
Conservation Division  
State Corporation Commission  
212 North Market, Insurance Bldg.  
Wichita, Kansas

15-039-00554-00-00

WELL PLUGGING RECORD

NORTH

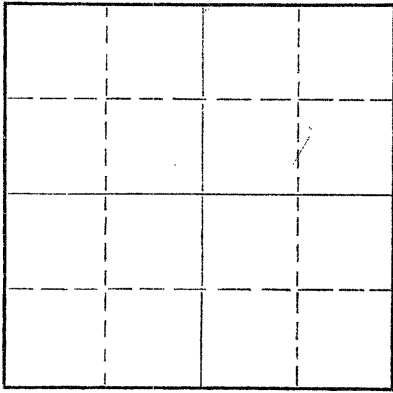

Locate well correctly on above  
Section Plat

DECATUR County. Sec. 15 Twp. 8 Rge. 27 (E) (W)  
Location as "NE/CNW/SW" or footage from lines SW NW SW  
Lease Owner MR. SOLAR & E. J. OARBY DRILLING CO.  
Lease Name MONROE Well No. 28  
Office Address Box 680, Hutchinson, Kansas  
Character of Well (completed as Oil, Gas or Dry Hole) Not enough to produce  
Date well completed 2-25-54 19\_\_\_\_  
Application for plugging filed 7-24-61 19\_\_\_\_  
Application for plugging approved 19\_\_\_\_  
Plugging commenced 8-1-61 19\_\_\_\_  
Plugging completed 19\_\_\_\_  
Reason for abandonment of well or producing formation  
Not enough to produce  
If a producing well is abandoned, date of last production 7-31-61 19\_\_\_\_  
Was permission obtained from the Conservation Division or its agents before plugging was commenced? Yes

Name of Conservation Agent who supervised plugging of this well \_\_\_\_\_  
Producing formation K.O. LIMB Depth to top \_\_\_\_\_ Bottom \_\_\_\_\_ Total Depth of Well 3580' Feet  
Show depth and thickness of all water, oil and gas formations.

OIL, GAS OR WATER RECORDS

CASING RECORD

FORMATION	CONTENT	FROM	TO	SIZE	PUT IN	PULLED OUT
				<u>35/8</u>	<u>200' 135</u>	<u>Sax. None</u>
				<u>51/2</u>	<u>3580' 135</u>	<u>Sax.</u>

Describe in detail the manner in which the well was plugged, indicating where the mud fluid was placed and the method or methods used in introducing it into the hole. If cement or other plugs were used, state the character of same and depth placed, from \_\_\_\_\_ feet to \_\_\_\_\_ feet for each plug set.

PLUGGED BACK TO 3584' WITH ROCK, DUMPED 5 SAX. CEMENT. SHOT AND  
PULLED PIPE, MUD TO 200', SET ROCK BRIDGE INTO SURFACE PIPE,  
FILLED SURFACE PIPE WITH REDY MIX CEMENT TO TOP OF PIPE.

RECEIVED  
STATE CORPORATION COMMISSION

OCT 6 1961

CONSERVATION DIVISION  
Wichita, Kansas

(If additional description is necessary, use BACK of this sheet)  
Name of Plugging Contractor BERT SELF CASING PULLING CO.  
Address R.R. #4, HUTCHINSON KANSAS

10-6-61

STATE OF \_\_\_\_\_, COUNTY OF \_\_\_\_\_, SS.

(employee of owner) or (owner or operator) of the above-described well, being first duly sworn on oath, says: That I have knowledge of the facts, statements, and matters herein contained and the log of the above-described well as filed and that the same are true and correct. So help me God.

(Signature) Bert Self  
R.R. #4 Hutchinson Kansas  
(Address)

SUBSCRIBED AND SWORN TO before me this 2 day of Oct, 1961

My commission expires July 31 - 1965

Clara J. Bishop  
Notary Public.



15-039-00554-0000

H. E. ZOLLER & E. K. CAREY DRIG. CO.  
#2 MONAGHAN

SW NW SW Sec. 15-28-27W  
Decatur County, Kansas

Casing

8 5/8" Set @ 208'  
5 1/2" Set @ 3589'

CEMENT

135 Sacks  
125 Sacks

Comm: 2-25-54  
Comp: 6-6-54  
Total Depth: 3590'

RECEIVED  
OCT 17 1961  
CONSERVATION DIVISION  
Wichita, Kansas  
10-17-61

FORMATION

DEPTH

Sand	0 - 133
Sand	133 - 160
Shale	160 - 208
Sand - shale	208 - 355
Shale and shells	355 - 1005
Shale and sand	1005 - 1370
Shale w/streaks of sand	1370 - 1543
Sand	1543 - 1565
Sand & shale streaks	1565 - 1605
Shale and sand	1605 - 1770
Sand	1770 - 1815
Red shale and sand	1815 - 1935
Red bed and shale	1935 - 2142
Anhydrite	2142 - 2178
Shale and shells	2178 - 2310
Shale and shells	2310 - 2535
Shale	2535 - 2650
Shale	2650 - 2753
Shale and shells	2753 - 2790
Lime and shale	2790 - 2840
Lime and shale	2840 - 2905
Lime and shale	2905 - 3182
Lime <i>Top No.</i>	3182 - 3257
Lime and shale	3257 - 3346
Lime and shale	3346 - 3478
Lime	3478 - 3497
Lime - shale	3497 - 3528
Lime	3528 - 3572
Lime - shale	3572 - 3590

Dakota Sand?

STATE OF KANSAS )  
                          ) SS  
SEDGWICK COUNTY )

I hereby certify that the above information is true and correct to the best of my knowledge.

*Walter E. [Signature]*

Subscribed and sworn to before me this 11 day of March, 1954

*William [Signature]*  
Notary Public

My Commission Expires: October 29, 1955