

STATE OF KANSAS
STATE CORPORATION COMMISSION


Give All Information Completely
Make Required Affidavit
Mail or Deliver Report to:
Conservation Division
State Corporation Commission
211 No. Broadway
Wichita, Kansas

WELL PLUGGING RECORD

Decatur County. Sec. 12 Twp. 2S Rge. 28 (~~EX~~) (W)

Location as "NE/CNW%SW%" or footage from lines C NE NE
Lease Owner Rock Island Oil & Refining Co., Inc.
Lease Name Reeves Well No. 2
Office Address 321 West Douglas, Wichita, Kansas
Character of Well (completed as Oil, Gas or Dry Hole) dry hole
Date well completed September 19 1962
Application for plugging filed September 19 1962
Application for plugging approved September 19 1962
Plugging commenced September 19 1962
Plugging completed September 19 1962
Reason for abandonment of well or producing formation no oil or gas found in commercial quantities

NORTH

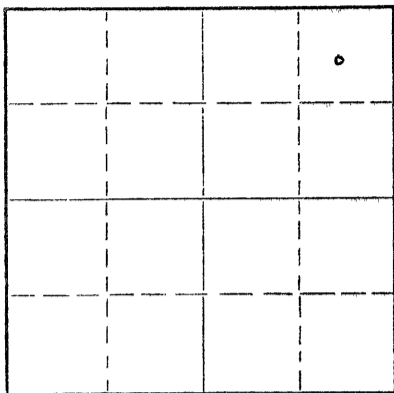

Locate well correctly on above Section Plat

If a producing well is abandoned, date of last production _____ 19____
Was permission obtained from the Conservation Division or its agents before plugging was commenced? yes

Name of Conservation Agent who supervised plugging of this well Eldon Petty
Producing formation _____ Depth to top _____ Bottom _____ Total Depth of Well 3600 Feet
Show depth and thickness of all water, oil and gas formations.

OIL, GAS OR WATER RECORDS

CASING RECORD

FORMATION	CONTENT	FROM	TO	SIZE	PUT IN	PULLED OUT
				8 5/8"	215	NONE

Describe in detail the manner in which the well was plugged, indicating where the mud fluid was placed and the method or methods used in introducing it into the hole. If cement or other plugs were used, state the character of same and depth placed, from _____ feet to _____ feet for each plug set.

Filled hole with mud to 550'. Set plug, cement with 20 sacks through drill pipe. Filled hole with mud to 180'. Set plug cement through drill pipe with 20 sacks. Filled hole to 40' of base of cellar. Set plug and 1/2 sack hulls and cement with 10 sacks

RECEIVED
STATE CORPORATION COMMISSION

SEP 23 1962

CONSERVATION DIVISION
Wichita, Kansas

9-26-62

(If additional description is necessary, use BACK of this sheet)

Name of Plugging Contractor Rains & Williamson Oil Co.
Address 412 Union Center, Wichita, Kansas

STATE OF KANSAS, COUNTY OF SEDGWICK, ss.
Wilson Rains - Partner (employee of owner) or (owner or operator) of the above-described well, being first duly sworn on oath, says: That I have knowledge of the facts, statements, and matters herein contained and the log of the above-described well as filed and that the same are true and correct. So help me God.

(Signature) Wilson Rains
Wilson Rains
412 Union Center, Wichita, Kansas
(Address)

SUBSCRIBED AND SWORN TO before me this 24th day of September, 1962

My commission expires JANET JOHNSON
My commission expires Jan. 25, 1965

Janet Johnson
Janet Johnson Notary Public.



15-039-00460-00-00

ROTARY DRILLING LOG

Operator: Rock Island Oil & Refining Co., Inc.
Contractor: Rains & Williamson Oil Co.
Commenced: 9/11/62
Completed: 9/19/62

Remarks: Set 8 5/8" at 215' with 125 sacks pozmix, 3% cc

NO. 2 REEVES, C NE NE Sec. 12-2S-28W, Decatur County, Kansas

FORMATIONS:

Surface Soil	15'
Sand	35'
Shale	215'
Sand & Shale	1515'
Sand & Shale	1735'
Anhydrite	2070'
Shale	2390'
Shale & Lime	2545'
Shale & Lime	2775'
Lime	2870'
Shale & Lime	3412'
Lime	3490'
Lime & Shale	3560'
Shale & Lime	3600'
RTD (D&A)	3600'

We certify the above log is true and correct to the best of our knowledge and belief.

RAINS & WILLIAMSON OIL CO.

By: *Wilson Rains*
Wilson Rains
Partner

Subscribed and sworn to before me, a Notary Public, in and for the State of Kansas, County of Sedgwick, this 24th day of September, 1962.

Janet Johnson
Janet Johnson, Notary Public

JANET JOHNSON
My commission expires Jan. 25, 1965

RECEIVED
STATE CURATOR'S COMMISSION

SEP 20 1962

CONSERVATION DIVISION
Wichita, Kansas

9-26-62