

15-039-00458-00-00


WELL PLUGGING RECORD

Give All Information Completely
Make Required Affidavit
Mail or Deliver Report to:
Conservation Division
State Corporation Commission
211 No. Broadway
Wichita, Kansas

Decatur County, Sec. 12 Twp. 2S Rge. 28W (W)

Location as "NE/CNW%SW%" or footage from lines C SW SW
Lease Owner Rains & Williamson Oil Co.
Lease Name Anna Miller Well No. 2-D
Office Address 412 Union Center, Wichita 2, Kansas
Character of Well (completed as Oil, Gas or Dry Hole) dry hole
Date well completed July 3 1962
Application for plugging filed July 3 1962
Application for plugging approved July 3 1962
Plugging commenced July 3 1962
Plugging completed July 3 1962
Reason for abandonment of well or producing formation _____

NORTH

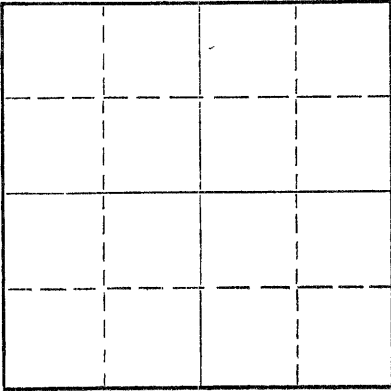

Locate well correctly on above
Section Plat

If a producing well is abandoned, date of last production _____ 19____
Was permission obtained from the Conservation Division or its agents before plugging was commenced? yes

Name of Conservation Agent who supervised plugging of this well Eldon Petty
Producing formation _____ Depth to top _____ Bottom _____ Total Depth of Well 1790 Feet
Show depth and thickness of all water, oil and gas formations.

OIL, GAS OR WATER RECORDS

CASING RECORD

FORMATION	CONTENT	FROM	TO	SIZE	PUT IN	PULLED OUT
				8 5/8"	175'	none

Describe in detail the manner in which the well was plugged, indicating where the mud fluid was placed and the method or methods used in introducing it into the hole. If cement or other plugs were used, state the character of same and depth placed, from _____ feet to _____ feet for each plug set.

Set plug at 550* and cement through drill pipe with 20 sacks cement, fill hole with mud up to 170* and set plug and cement through drill pipe and with 20 sacks. Fill hole up to 35* of base of cellar and set plug and cap with 10 sacks cement.

(If additional description is necessary, use BACK of this sheet)

Name of Plugging Contractor Rains & Williamson Oil Co.
Address 412 Union Center, Wichita 2, Kansas

STATE OF KANSAS, COUNTY OF SEDGWICK, ss.

Lloyd R. Williamson Partner (employee of owner) or (owner or operator) of the above-described well, being first duly sworn on oath, says: That I have knowledge of the facts, statements, and matters herein contained and the log of the above-described well as filed and that the same are true and correct. So help me God.

(Signature) Lloyd R. Williamson
Lloyd R. Williamson
412 Union Center, Wichita 2, Kansas
(Address)

SUBSCRIBED AND SWORN TO before me this 9th day of July, 19 62

My commission expires JANET JOHNSON
My commission expires Jan. 25, 1965

Janet Johnson
Janet Johnson Notary Public.

INVOICED

DATE 9/11/62
INV. NO. 5352-u