


15-039-20466-00-01

WELL PLUGGING RECORD

Give All Information Completely
 Make Required Affidavit

COUNTY Decatur SEC. 16 TWP. 2-s RGE. 28 N/W
 Location as in quarters or footage from lines:
C NE NE

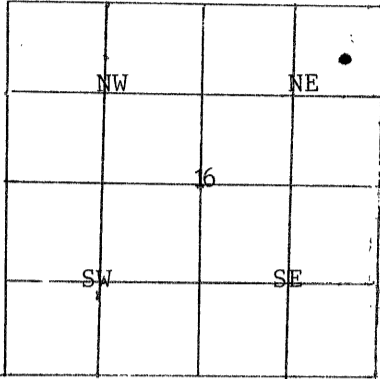

Locate Well
 correctly on above
 Section Platt.

Lease Owner Cherokee Petroleum Corporation
 Lease Name Kreymborg Well No. 1
 Office Address 410 Seventeenth, Suite 2300, Denver, Colorado
 Character of Well (Completed as Oil, Gas or Dry Hole): Oil
 Date Well Completed January 15, 1981
 Application for plugging filed May 12, 1982
 Plugging commenced May 24, 1982
 Plugging completed July 19, 1982
 Reason for abandonment of well or producing formation
Well failed to produce hydrocarbon shows in paying quantities
 Was permission obtained from the Conservation Division or it's
 Agent's before plugging was commenced? yes

Name of Conservation Agent who supervised plugging of this well Carl Goodrow
 Producing formation LKC Depth to top 3533' bottom 3751' T.D. 3830'
 Show depth and thickness of all water, oil and gas formations.

OIL, GAS OR WATER RECORDS (See reverse side for continued formations) Casing Record

Formation	Content	From	To	Size	Put in	Pulled Out
A-Zone	Oil/Water	3553'	3558'	8 5/8"	189'	
B-Zone	Oil/Water	3594'	3598'	4 1/2"	3824'	
C-Zone	Oil/Water	3632'	3636'			
D-Zone	Oil/Water	3665'	3668'			
E-Zone	Oil/Water	3705'	1/s	(SEE REVERSE SIDE)		

Describe in detail the manner in which the well was plugged, indicating where the mud fluid was placed and the method or methods used in introducing it into the hold. If cement or other plugs were used, state the character of same and depth placed, from _____ feet to _____ feet for each plug set.

Set plug at 2626' / 5 sacks cement (5-18-82), 4 sacks hulls, 20 sacks gel (4% gel, 3% cc), 60 sacks cement (50/50 pos), plug 8 5/8", 10 sacks cement (50/50 pos). (7-19-82)

(If additional description is necessary, use BACK of this sheet)

Name of Plugging Contractor Rocky Mountain Well Service Company Halliburton Co.
Oil Field Service & Supply, Inc.

STATE OF KANSAS COUNTY OF DECATUR, ss.
James R. Betts, operator (employee of owner) or (owner or operator) of the above-described well, being first duly sworn on oath, says: That I have knowledge of the facts, statements, and matters herein contained and the log of the above-described well as filed and that the same are true and correct. So help me God. PETRO-MINING RESOURCES, INC.

(Signature) James R. Betts
James R. Betts, President
 (Address) P.O. Drawer 298, Oberlin, KS

SUBSCRIBED AND SWORN TO before me this 20th day of July, 19 82

Rhonda Salem RECEIVED
 STATE CORPORATION COMMISSION
 Notary Public.

My Commission expires: December 4, 1985

JUL 22 1982

CONSERVATION DIVISION
 Wichita, Kansas

7-22-82

