


WELL PLUGGING RECORD

Give All Information Completely  
Make Required Affidavit  
File or Deliver Report to:  
Conservation Division  
State Corporation Commission  
211 No. Broadway  
Wichita, Kansas

Decatur County, Sec. 16 Twp. 2S Rge. 28 (E) (W)

NORTH

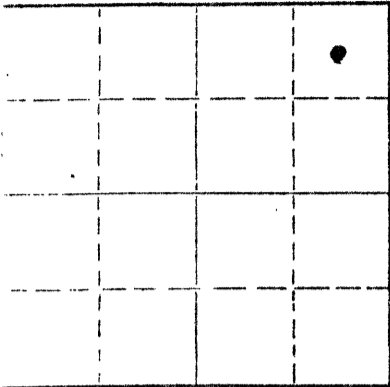

Locate well correctly on above  
Section Plat

Location as "NE/CNW/SW" or footage from lines \_\_\_\_\_  
Lease Owner Dane G. Hansen Trust  
Lease Name Kreymborg Well No. 1  
Office Address Box 185 Logan, KS  
Character of Well (completed as Oil, Gas or Dry Hole) Dry Hole  
Date well completed September 9, 1979 19 79  
Application for plugging filed September 9 19 79  
Application for plugging approved September 9 19 79  
Plugging commenced September 9 19 79  
Plugging completed September 9 19 79  
Reason for abandonment of well or producing formation Dry Hole

If a producing well is abandoned, date of last production None 19 \_\_\_\_  
Was permission obtained from the Conservation Division or its agents before plugging was commenced? Yes

Name of Conservation Agent who supervised plugging of this well Gilbert Balthazor  
Producing formation None Depth to top \_\_\_\_\_ Bottom \_\_\_\_\_ Total Depth of Well 4132 Feet  
Show depth and thickness of all water, oil and gas formations.

OIL, GAS OR WATER RECORDS

CASING RECORD

FORMATION	CONTENT	FROM	TO	SIZE	PUT IN	PULLED OUT
Shale	Water	0	187	8 5/8	9-29-79	

Describe in detail the manner in which the well was plugged, indicating where the mud fluid was placed and the method or methods used in introducing it into the hole. If cement or other plugs were used, state the character of same and depth placed, from \_\_\_\_\_ feet to \_\_\_\_\_ feet for each plug set.  
70 Sacks of 50/50 Pos. Mix-6% Gel pumped by Halliburton at 1250 Feet  
20 Sacks at 200 Feet and 20 Sacks at 40 Feet  
5 Sacks in Rat Hole

Name of Plugging Contractor J & C Drilling Company Inc.  
Address 106 West 8th Street McCook, NE 69001  
(If additional description is necessary, use BACK of this sheet)  
RECEIVED  
STATE CORPORATION COMMISSION  
10-11-79  
OCT 11 1979

STATE OF Nebraska, COUNTY OF Red Willow, CONSERVATION DIVISION  
John Cartwright, ss: Wichita, Kansas  
(employee of owner) or (owner or operator) of the above-described well, being first duly sworn on oath, says: That I have knowledge of the facts, statements, and matters herein contained and the log of the above-described well as filed and that the same are true and correct. So help me God.

(Signature) John Cartwright  
106 West 8th McCook NE 69001 (Address)

SUBSCRIBED AND SWORN TO before me this 3rd day of Oct, 19 79  
Bert E. Blackwell

Notary Public. My commission expires July 12, 1982

