


15-039-20319-00-00

STATE OF KANSAS
STATE CORPORATION COMMISSION

Give All Information Completely
Make Required Affidavit
Mail or Deliver Report to:
Conservation Division
State Corporation Commission
P. O. Box 17027
Wichita, Kansas 67217
NORTH

WELL PLUGGING RECORD

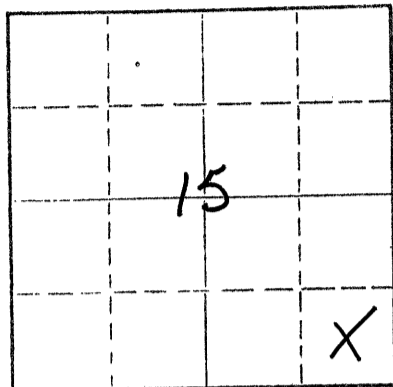

Locate well correctly on above
Section Plat

Decatur County, Sec. 15 Twp. 2S. Rge. 28(W) (X)
Location as "NE/CNW/SW" or footage from lines C SE SE

Lease Owner: Abercrombie Drilling, Inc.

Lease Name: PARK COLLEGE Well No. #1

Office Address: 801 Union Center, Wichita, Kansas 67202

Character of Well (completed as Oil, Gas or Dry Hole) Dry Hole

Date well completed October 17, 1975

Application for plugging filed (verbally) October 17, 1975

Application for plugging approved (verbally) October 17, 1975

Plugging commenced October 17, 1975

Plugging completed October 17, 1975

Reason for abandonment of well or producing formation No commercial quantity of oil or gas encountered

If a producing well is abandoned, date of last production 19

Was permission obtained from the Conservation Division or its agents before plugging was commenced? Yes

Name of Conservation Agent who supervised plugging of this well Gilbert Balthazor

Producing formation _____ Depth to top _____ Bottom _____ Total Depth of Well 3685 Feet

Show depth and thickness of all water, oil and gas formations:

OIL, GAS OR WATER RECORDS

CASING RECORD

FORMATION	CONTENT	FROM	TO	SIZE	PUT IN	PULLED OUT
				8 5/8"	219'	None

Describe in detail the manner in which the well was plugged, indicating where the mud fluid was placed and the method or methods used in introducing it into the hole. If cement or other plugs were used, state the character of same and depth placed, from _____ feet to _____ feet for each plug set.

1st Plug Set @ 1200' with 70 sx. cement
2nd Plug Set @ 200' with 20 sx. cement
3rd Plug Set @ 40' with 10 sx. cement
Plug was down @ 7:45 a.m. October 17, 1975

RECEIVED
STATE CORPORATION COMMISSION
OCT 22 1975
CONSERVATION DIVISION
Wichita, Kansas
10-22-75

(If additional description is necessary, use BACK of this sheet)

Name of Plugging Contractor: Abercrombie Drilling, Inc.
Address: 801 Union Center, Wichita, Kansas 67202

STATE OF KANSAS, COUNTY OF SEDGWICK, ss.

Jerry A. Langrehr-Exec. V.P. (employee of owner) or (owner or operator) of the above-described well, being first duly sworn on oath, says: That I have knowledge of the facts, statements, and matters herein contained and the log of the above-described well as filed and that the same are true and correct. So help me God.

(Signature) Jerry A. Langrehr
801 Union Center, Wichita, Ks.
(Address)

Subscribed and sworn to before me this 21st day of October, 1975



Sandra Russell
Sandra Russell
Notary Public.