

TO:
STATE CORPORATION COMMISSION
CONSERVATION DIVISION - PLUGGING
130 SOUTH MARKET, SUITE 2078
WICHITA, KANSAS 67202

API Well Number: 15-009-21537-00-00
Spot: NENWSE Sec/Twnshp/Rge: 8-16S-11W
2310 feet from S Section Line, 1650 feet from E Section Line
Lease Name: WIRTH Well #: 3
County: BARTON Total Vertical Depth: 3368 feet

Operator License No.: 6622
Op Name: SCHOENBERGER, J.L. D/B/A JASON OIL
Address: PO BOX 701 363 W 12TH ST
RUSSELL, KS 67665

PROD Size: 4.5 feet: 3367
SURF Size: 8.625 feet: 345

10946

Well Type: OIL UIC Docket No: _____ Date/Time to Plug: 06/28/2004 1:00 PM
Plug Co. License No.: 32810 Plug Co. Name: PROFESSIONAL PULLING SERVICES LLC
Proposal Rcvd. from: JIM SCHOENBERGER Company: JASON OIL COMPANY Phone: (785) 483-4204

Proposed Plugging Method: Ordered 425 sxs 60/40 pozmix - 10% gel - 1200# hulls.
Emergency plug with rig over the hole.
Squeeze at 400' - 1500' - 2100'.
Bad casing.

Plugging Proposal Received By: HERB DEINES WitnessType: COMPLETE (100%)
Date/Time Plugging Completed: 06/28/2004 5:30 PM KCC Agent: PAT STAAB

Actual Plugging Report:

Professional Well Services RIH with tubing to 2000' - pumped 75 sxs 60/40 pozmix with 500# hulls mixed in.
Pulled tubing to 1300' - spotted 50 sxs 60/40 pozmix with 100# hulls mixed in.
Pulled tubing to 750' - pumped 50 sxs 60/40 pozmix with 100# hulls mixed in.
Pulled tubing to 400' - pumped 50 sxs 60/40 pozmix - well went on vacuum.
Pulled tubing and left set for 1 1/2 hours - dug out backside and pressured to 500# with 1/4 barrel slurry.
Tied onto 4 1/2" casing - pumped 100 sxs 60/40 pozmix with 500# hulls mixed in.
Took off swedge and topped with 80 sxs cement.
Hole was standing full of cement.

Perfs:

Top	Bot	Thru	Comments
3316	3322		
3181	3186		


RECEIVED
JUN 30 2004
KCC WICHITA

Remarks: ALLIED CEMENTING COMPANY-TICKET #16910.

Plugged through: TBG

District: 04

Signed _____

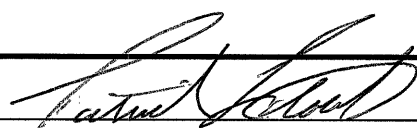

(TECHNICIAN)

INVOICED

DATE 6-30-04

CALL NO. 2004061799

JUN 29 2004

THE ROXANA CORPORATION

P. O. BOX 1162

GREAT BEND, KS. 67530

CONTR. WOODMAN & JANNETTI DRGL. CTY. BARTON

8-16-11W
NE NW SE

#3 WIRTH

GEOL. JIM MUSGROVE

FIELD KRAFT-PRUSA

E 1845 KB CM 1/9/79 CARD ISSUED 3/31/79 IP

P 75 BOPD,

LKC 3181-3186 &
ARB 3316-3322
COMMINGLED

+	+	+
+	+	+
+	+	+

API 15-009-21,537

LOG	TOPS	DEPTH	DATUM
ANH	711	-1135	
HEEB	2887	-1041	
TOR	2906	-1050	
DOUG	2919	-1073	
BR LM	2980	-1134	
LANS	2995	-1149	
BKC	3272	-1426	
CONG	3295	-1449	
ARB	3303	-1457	
RTD	3368	-1522	
LTD	3368	-1522	

8-5/8" 345, 4 1/2" 3367
 DST (1) 3131-3150/30-30-30, REC 15'
 0 SPK M, SIP 55-44#, FP 33-33/33-33#
 DST (2) 3178-3200/30-30-30, REC 980'
 GIP, 20' HOOM, 140' MGO, 40' MW,
 SIP, 898-887#, FP 33-66/78-100#
 DST (3) 3290-3310/45-45-45, REC 60'
 GIP 1310' CGO, 180' MGO, SIP 920-
 898#, FP 66-334/345-468#
 DST (4) 3313-3324/30-30-30, REC 60'
 GIP, 1400 GCO, 240' MO, SIP 832-
 821#, FP 223-491/557-667#
 MICT - CO, PF 3316-22, SWB 6 BPH, 100%
 O, SD, BAILED 2500 FTH, 300' WTR ON BTM
 PB 3200' PF 3181-3186, SWB 10 GOPH
 (OVER)

INDEPENDENT OIL & GAS SERVICE
WICHITA, KANSAS

THE ROXANA CORPORATION

#3 WIRTH

8-16-11W
NE NW SE

NAT, AC 1000 GAL SD, SWB 12 BOPH, 15% WTR, DRILLED PLUG TO BTM
FL 1850' FROM TOP, POP, P 75 BOPD