

8-13-80  
AUG 13 1980

15-039-20520-00-00

CONSERVATION DIVISION  
Wichita, Kansas


FORM CP-4

STATE OF KANSAS  
STATE CORPORATION COMMISSION

WELL PLUGGING RECORD

Give All Information Completely  
Make Required Affidavit  
Mail or Deliver Report to  
Conservation Division  
State Corporation Comm.  
245 North Water  
Wichita, KS 67202

Decatur County. Sec. 27 Twp. 2S Rge. 28 E/W  
Location as "NE/CNW1SW1" or footage from lines  
SWNWNE  
Lease Owner Petro-Mining Resources, Inc. & Cherokee Pet. Corp.  
Lease Name Fisher Well No. 1  
Office Address 2300 - 410 Building, Denver, CO 80202  
Character of Well (Completed as Oil, Gas or Dry Hole) \_\_\_\_\_

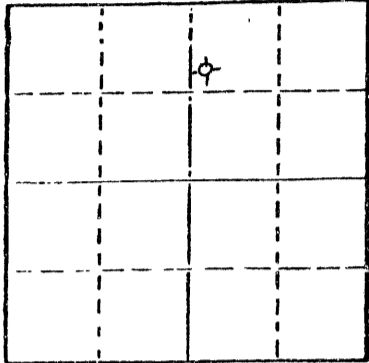

Locate well correctly on above  
Section Plot

Dry hole  
Date Well completed August 10 1980  
Application for plugging filed August 10 1980  
Application for plugging approved \_\_\_\_\_ 19\_\_\_\_  
Plugging commenced August 10 1980  
Plugging completed August 10 1980  
Reason for abandonment of well or producing formation \_\_\_\_\_  
Non-economic in Toronto & KC-L  
If a producing well is abandoned, date of last production \_\_\_\_\_ 19\_\_\_\_

Was permission obtained from the Conservation Division or its agents before plugging was commenced? Yes

Name of Conservation Agent who supervised plugging of this well Clarence F. Thomas, Jr.  
Producing formation None Depth to top \_\_\_\_\_ Bottom \_\_\_\_\_ Total Depth of Well 3845 L  
Show depth and thickness of all water, oil and gas formations.

OIL, GAS OR WATER RECORDS

CASING RECORD

FORMATION	CONTENT	FROM	TO	SIZE	PUT IN	PULLED OUT
Toronto	wet	3600	3605			
KC-Ls	wet	3600	3824			
				8 5/8	166	

Describe in detail the manner in which the well was plugged, indicating where the mud fluid was placed and the method or methods used in introducing it into the hold. If cement or other plugs were used, state the character of same and depth placed, from \_\_\_\_\_ feet to \_\_\_\_\_ feet for each plug set.

P & A 6:00 am 8/10/80  
70 sax at 750' -840'  
20 sax at 166' -135'  
10 sax at surface cut off 1' below plow depth and plated.

drilling mud 3845-840, 750-166, 135-20'

(If additional description is necessary, use BACK of this sheet)

Name of Plugging Contractor Sun Cementing

STATE OF Colorado COUNTY OF Denver, ss.  
Courtney E. Cook (employee of owner) or (owner or operator)  
of the above-described well, being first duly sworn on oath, says: That I have knowledge of the facts, statements, and matters herein contained and the log of the above-described well as filed and that the same are true and correct. So help me God.

(Signature) Courtney E Cook  
Suite 2300 - 410 Bldg, Denver, CO 80202  
(Address)

SUBSCRIBED AND SWORN TO before me this 11th day of August, 1980

Christine M. Cleveland  
Notary Public.

My commission expires 2-14-83