


15-039-20474-00-00

STATE OF KANSAS
STATE CORPORATION COMMISSION

WELL PLUGGING RECORD

Give All Information Completely
Make Required Affidavit
Mail or Deliver Report to
Conservation Division
State Corporation Comm.
245 North Water
Wichita, KS 67202

Decatur County, Sec. 23 Twp. 2S Rge. 28 W
Location as "NE/CNW $\frac{1}{4}$ SW $\frac{1}{4}$ " or footage from lines
C-NE-NW
Lease Owner Murfin Drilling Co.
Lease Name Rush Well No. 3
Office Address 250 N. Water Suite 300 Wichita, Ks 67202
Character of Well (Completed as Oil, Gas or Dry Hole)
Oil Well
Date Well completed. 12/26/79 19
Application for plugging filed 2-25-85 19
Application for plugging approved 2-26-85 19
Plugging commenced 2-27-85 19
Plugging completed 3-6-85 19
Reason for abandonment of well or producing formation
Not economical
If a producing well is abandoned, date of last production
2-24-85 19
Was permission obtained from the Conservation Division or
its agents before plugging was commenced? Yes

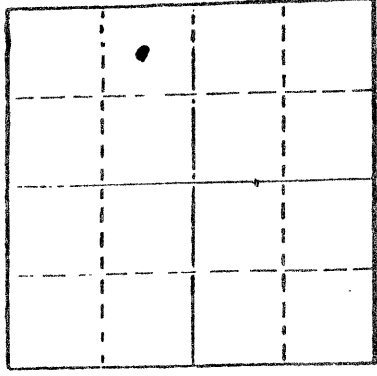

Locate well correctly on above
Section Plat

Name of Conservation Agent who supervised plugging of this well Carl Goodrow
Producing formation L/KC Depth to top 3505 Bottom 3665 Total Depth of Well 3720
Show depth and thickness of all water, oil and gas formations.

OIL, GAS OR WATER RECORDS

CASING RECORD

FORMATION	CONTENT	FROM	TO	SIZE	PUT IN	PULLED OUT
L/KC	Oil & SW	3505	3665	4 $\frac{1}{2}$ "	3713	0'

Describe in detail the manner in which the well was plugged, indicating where the mud fluid was placed and the method or methods used in introducing it into the hold. If cement or other plugs were used, state the character of same and depth placed, from _____ feet to _____ feet for each plug set. Halliburton pumped down 4 $\frac{1}{2}$ " casing, 3 sx hulls out perforations, 50 sx 50-50 Poz cement, 34 sx out perforations and 16 sx in casing covering 3670 to 3402', 9 sx gel covering 3402 to 2268', 10 sx 50-50 Poz cement covering 2268 to 2079', 6 sx gel covering 2079 to 1323', 1 sx hulls covering 1323 to 1197', 4 $\frac{1}{2}$ " wiper plug, 70 sx 50-50 Poz cement covering 1197' to surface. Shut in 4 $\frac{1}{2}$ " casing with 1200 psi. Pumped 50 sx 50-50 Poz cement down 8 5/8" casing covering 256' to surface. Shut in with 200 psi. Job completed @ 5:00 P.M. 3/6/85.

(If additional description is necessary, use BACK of this sheet)


Name of Plugging Contractor _____

STATE OF Kansas COUNTY OF Sedgwick, ss.
L.O. Butner, Western Division, Prod. Manager (employee of owner) or ~~(owner)~~
of the above-described well, being first duly sworn on oath, says: That I have knowledge of the facts, statements, and matters herein contained and the log of the above-described well as filed and that the same are true and correct. So help me God.

(Signature By: L.O. Butner
250 N. Water, Suite 300; Wichita, KS 67202
(Address)

SUBSCRIBED AND SWORN TO before me this 13 day of March, 1985

My commission expires 2/6/86

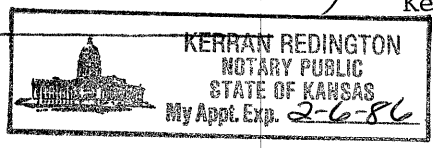

Kerran Redington
Kerran Redington Notary Public.

RECEIVED
STATE CORPORATION COMMISSION
3-14-85
MAR 14 1985
CONSERVATION DIVISION
Wichita, Kansas