


15-039-20424-00-00

STATE OF KANSAS
STATE CORPORATION COMMISSION

Give All Information Completely
Make Required Affidavit
Mail or Deliver Report to:
Conservation Division
State Corporation Commission
212 North Market, Insurance Bldg.
Wichita, Kansas

WELL PLUGGING RECORD

Decatur County. Sec. 22 Twp. 2S Rge. 28W (E) (W)
Location as "NE/CNW/SW" or footage from lines C SW SW
Lease Owner John O. Farmer, Inc.
Lease Name BREMER Well No. #1
Office Address Box 352 Russell, Kansas 67665
Character of Well (completed as Oil, Gas or Dry Hole) Dry Hole
Date well completed 7-27-78 19
Application for plugging filed Yes 19
Application for plugging approved 19
Plugging commenced 19
Plugging completed 12:30 p.m. 7-27-78 19
Reason for abandonment of well or producing formation

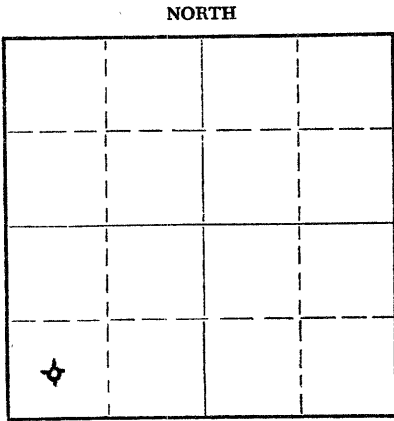

Locate well correctly on above
Section Plat

If a producing well is abandoned, date of last production 19
Was permission obtained from the Conservation Division or its agents before plugging was commenced? Yes

Name of Conservation Agent who supervised plugging of this well Gilbert Balthazor
Producing formation Depth to top Bottom Total Depth of Well Feet
Show depth and thickness of all water, oil and gas formations.

OIL, GAS OR WATER RECORDS

CASING RECORD

FORMATION	CONTENT	FROM	TO	SIZE	PUT IN	PULLED OUT

Describe in detail the manner in which the well was plugged, indicating where the mud fluid was placed and the method or methods used in introducing it into the hole. If cement or other plugs were used, state the character of same and depth placed, from feet to feet for each plug set.

Plug #1 1150' w/70 sx. Cement
Plug #2 200' w/20 sx. Cement
Plug #3 40' w/10 sx. Cement

RECEIVED
STATE CORPORATION COMMISSION
AUG 02 1978
8-2-78
CONSERVATION DIVISION
Wichita, Kansas

(If additional description is necessary, use BACK of this sheet)


Name of Plugging Contractor John O. Farmer, Inc.
Address Box 352 Russell, Kansas 67665

STATE OF Kansas, COUNTY OF Russell, ss.
John O. Farmer (employee of owner) or (owner or operator) of the above-described well, being first duly sworn on oath, says: That I have knowledge of the facts, statements, and matters herein contained and the log of the above-described well as filed and that the same are true and correct. So help me God.

(Signature) John O. Farmer
Box 352 Russell, Kansas 67665 (Address)

SUBSCRIBED AND sworn to before me this 28th day of July, 1978

My commission expires February 15, 1979

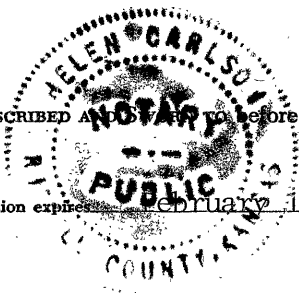

Helen Carlson Notary Public.

KANSAS DRILLERS LOG

API No. 15 - 039 - 20424-00-00
 County Number

S. 22 T. 2S R. 28W E
 W
 Loc. C SW SW

County Decatur

Operator
John O. Farmer, Inc.

Address
Box 352 Russell, Kansas 67665


Well No. # 1 Lease Name BREMER

Footage Location
660 feet from (S) line 660 feet from (W) line

Principal Contractor John O. Farmer, Inc. Geologist Sam Farmer

Spud Date 7-20-78 Total Depth 3740' P.B.T.D.

Date Completed 7-28-78 Oil Purchaser

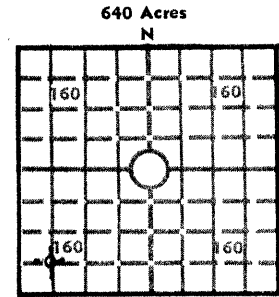

Locate well correctly
 Elev.: Gr. 2532'
 DF 2535' KB 2537'

CASING RECORD

Report of all strings set—surface, intermediate, production, etc.

Purpose of string	Size hole drilled	Size casing set (in O.D.)	Weight lbs/ft.	Setting depth	Type cement	Sacks	Type and percent additives
Surface	12 1/4	8-5/8"	26	215'	Common	170	

LINER RECORD

PERFORATION RECORD

Top, ft.	Bottom, ft.	Sacks cement	Shots per ft.	Size & type	Depth interval

Size	Setting depth	Packer set at

ACID, FRACTURE, SHOT, CEMENT SQUEEZE RECORD

Amount and kind of material used	Depth interval treated
<u>8-2-78</u>	

INITIAL PRODUCTION

Date of first production _____ Producing method (flowing, pumping, gas lift, etc.) _____

RATE OF PRODUCTION PER 24 HOURS	Oil	Gas	Water	Gas-oil ratio
	bbis.	MCF	bbis.	CFPB

Disposition of gas (vented, used on lease or sold) _____ Producing interval(s) _____

INSTRUCTIONS: As provided in KCC Rule 82-2-125, within 90 days after completion of a well, one completed copy of this Drillers Log shall be transmitted to the State Geological Survey of Kansas, 4150 Monroe Street, Wichita, Kansas 67209. Copies of this form are available from the Conservation Division, State Corporation Commission, 3830 So. Meridian (P.O. Box 17027), Wichita, Kansas 66217. Phone AC 316-522-2206. If confidential custody is desired, please note Rule 82-2-125. Drillers Logs will be on open file in the Oil and Gas Division, State Geological Survey of Kansas, Lawrence, Kansas 66044.

RECEIVED
 STATE CORPORATION COMMISSION
 AUG 02 1978
 CONSERVATION DIVISION
 Wichita, Kansas

Operator: John O. Farmer, Inc. DESIGNATE TYPE OF COMP.: OIL, GAS, DRY HOLE, SWDOW, ETC.:

Well No. #1 Lease Name BREMER DRY HOLE

S 22 T 2S R 28 W

WELL LOG
 Show all important zones of porosity and contents thereof; cored intervals, and all drill-stem tests, including depth interval tested, cushion used, time tool open, flowing and shut-in pressures, and recoveries. SHOW GEOLOGICAL MARKERS, LOGS RUN, OR OTHER DESCRIPTIVE INFORMATION.

FORMATION DESCRIPTION, CONTENTS, ETC.	TOP	BOTTOM	NAME	DEPTH
Clay	-0-	50		
Sand	50	70		
Blue Shale	70	215		
Shale	215	845		
Shale & Sand	845	1945		
Sand	1945	2095		
Red Bed	2095	2207		
Anhydrite	2207	2238		
Shale & Shells	2238	2610		
Shale & Lime	2610	3455		
Lime	3455	3725		
<p>DST #1 3523' to 3565' Tool Open 30-30-60-60; Strong blow Rec: 5' oil; 1200' muddy water IFP: 41-262 FFP: 278-604 BHP: 1302-1302</p> <p>DST #2 3635' to 3671' Tool Open 15 min.; shut in 30 min. Open 5 min; weak blow 13 min. Rec: 10' mud, scum of oil IFP: 33-33 IBHP: 82#</p>				

USE ADDITIONAL SHEETS, IF NECESSARY, TO COMPLETE WELL RECORD.

Date Received _____

Signature: *John O. Farmer*
 Title: President
 Date: July 28, 1978