

STATE OF KANSAS
STATE CORPORATION COMMISSION
130 S. Market, Room 2078
Wichita, KS 67202

WELL PLUGGING RECORD
K.A.R.-82-3-117

API NUMBER 15-129-21273-00-00

LEASE NAME JOHNS

WELL NUMBER 5-1

TYPE OR PRINT
NOTICE: Fill out completely
and return to Cons. Div.
office within 30 days.

330 Ft. from S Section Line

1200 Ft. from E Section Line

LEASE OPERATOR DUKE ENERGY FIELD SERVICES, L.P.

SEC. 1 TWP. 32 RGE. 42 (E) or (W)

ADDRESS 6120 S. YALE, SUITE 1100 TULSA, OK

COUNTY MORTON

PHONE: (918) 492-3331 OPERATORS LICENSE NO. 32782

Date Well Completed 5/6/1994

Character of Well GAS STORAGE

Plugging Commenced 6/4/2004

(Oil, Gas, O&A, SWD, Input, Water Supply Well)

Plugging Completed 6/7/2004

The plugging proposal was approved on 5/3/2004 (date)

by S. DURRANT (KCC District Agent's Name).

Is ACO-1 filed? YES If not, is well log attached?

Producing Formation G2/KEYES Depth to Top 4958/5023 Bottom 5001/5044 T.D. 5176 5173

Show depth and thickness of all water, oil and gas formations.

OIL, GAS OR WATER RECORDS

CASING RECORD

Formation	Content	From	To	Size	Put In	Pulled out
PERMIAN	FRESH WATER	200	400	9 5/8	1472	- 0 -
G2/KEYES	GAS	4958	5044	7"	5176	1500

RECEIVED
KANSAS CORPORATION COMMISSION

Describe in detail the manner in which the well was plugged, indicating where the mud plug was placed and the method or methods used in introducing it into the hole. If cement or other plug were used, state the character of same and depth placed, from ___ feet to ___ feet each set.
PLUGGED AS PER KCC REQUIREMENTS

JUL 8 2004
CONSERVATION DIVISION
WICHITA, KS

SEE ATTACHMENT

Name of Plugging Contractor EAGLE WELL SERVICE, INC License No. 7407

Address P.O. BOX 1597 LIBERAL, KS 67905-1597

NAME OF PARTY RESPONSIBLE FOR PLUGGING FEES: DUKE ENERGY FIELD SERVICES, L.P.

STATE OF OKLAHOMA COUNTY OF TULSA, ss.

Paul Brewer (Employee of Operator) or (Operator) o above-described well, being first duly sworn on oath, says: That I have knowledge of the facts statements, and matters herein contained and the log of the above-described well as filed tha the same are true and correct, so help me God.


(Signature) Paul Brewer

(Address) 6120 S. Yale Ave, Ste 1100, Tulsa, OK 74135

SUBSCRIBED AND SWORN TO before me this 6th day of July, 2004


Sylvia B. Powell
Notary Public

My Commission Expires: 8-31-2007

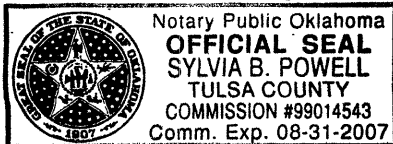

Duke Energy Field Services

Plug and Abandonment Schematic

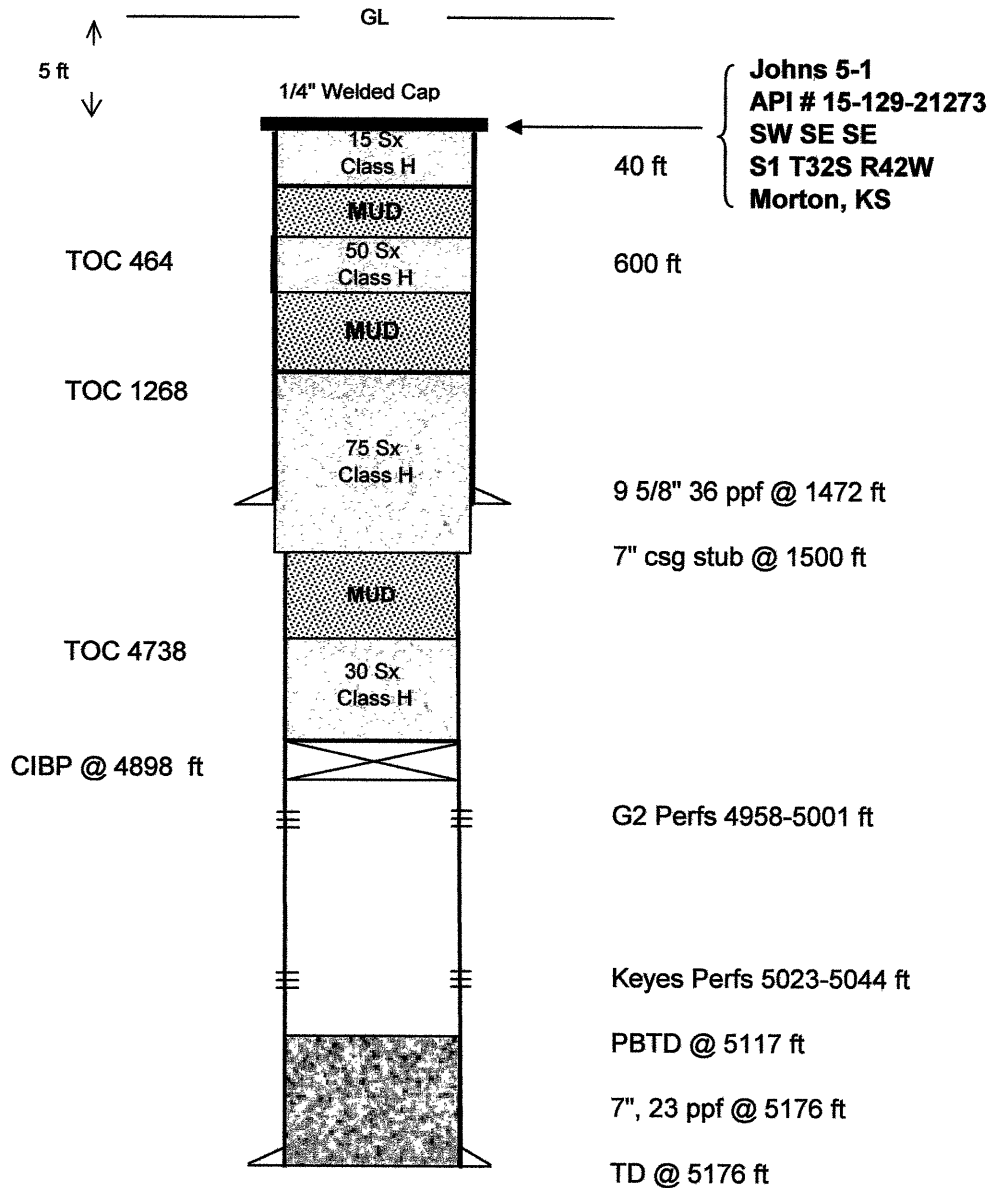

Plug and Abandonment Details:

Date Well Completed: May 6, 1994

Plugging Commenced: June 4, 2004

Plugging Completed: June 7, 2004

RECEIVED
KANSAS CORPORATION COMMISSION

JUL 08 2004

CONSERVATION DIVISION
WICHITA, KS