

15-039-00111-00-00

STATE OF KANSAS
STATE CORPORATION COMMISSION

Give All Information Completely
Make Required Affidavit
Mail or Deliver Report to:
Conservation Division
State Corporation Commission
800 Bitting Building
Wichita, Kansas

WELL PLUGGING RECORD

Decatur County. Sec. 34 Twp. 2S Rge. 28 (E) W (W)

Location as "NE/CNW/SW" or footage from lines NW/4 NW/4 NE/4

Lease Owner Wood River Oil & Refining Co.

Lease Name Allen Well No. 1

Office Address 321 West Douglas, Wichita, Kansas

Character of Well (completed as Oil, Gas or Dry Hole) Dry Hole

Date well completed 12-20- 19 55

Application for plugging filed " " 19

Application for plugging approved " " 19

Plugging commenced " " 19


Plugging completed " " 19

Reason for abandonment of well or producing formation Dry and abandoned

If a producing well is abandoned, date of last production ---- 19

Was permission obtained from the Conservation Division or its agents before plugging was commenced? _____

NORTH

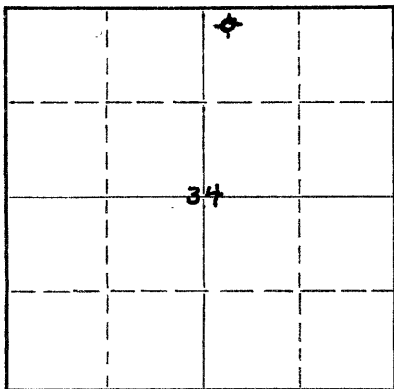

Locate well correctly on above Section Plat

Name of Conservation Agent who supervised plugging of this well _____

Producing formation ----- Depth to top ---- Bottom ----- Total Depth of Well 3841 Feet

Show depth and thickness of all water, oil and gas formations.

OIL, GAS OR WATER RECORDS

CASING RECORD

FORMATION	CONTENT	FROM	TO	SIZE	PUT IN	PULLED OUT
-----	-----	---	---	8-5/8" new csg. set at 220.61' cemented w/150 sx. of sx. cement & 2 Calcium Chloride.		

Describe in detail the manner in which the well was plugged, indicating where the mud fluid was placed and the method or methods used in introducing it into the hole. If cement or other plugs were used, state the character of same and depth placed, from _____ feet to _____ feet for each plug set.

Stirred pits. Filled hole with heavy mud to 190'. Set plug with 1/2 sack hulls and 15 sacks cement. Filled hole to 40' with 1/2 sack hulls and 10 sacks cement.

(If additional description is necessary, use BACK of this sheet)

Name of Plugging Contractor ~~XXXXXXXXXX~~ Heathman-Seeligson Drilling Co.

Address 1015 East Second, Wichita, Kansas

STATE OF Kansas, COUNTY OF Sedgwick, ss.


R. J. Loeffler (employee of owner) or (owner or operator) of the above-described well, being first duly sworn on oath, says: That I have knowledge of the facts, statements, and matters herein contained and the log of the above-described well as filed and that the same are true and correct. So help me God.

(Signature) *R. J. Loeffler*
1015 East Second, Wichita, Kansas
(Address)

SUBSCRIBED AND SWORN TO before me this 22 day of December, 1955

My commission expires June 28, 1956

D. Majorie Matt
Notary Public.

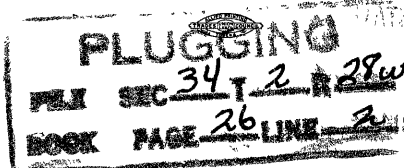

RECEIVED
DEC 29 1955 12-29-55
WICHITA, KANSAS