


Give All Information Completely
Make Required Affidavit
Mail or Deliver Report to:
Conservation Division
State Corporation Commission
211 No. Broadway
Wichita, Kansas

Decatur County, Sec. 33 Twp. 2S Rge. 28 (E) W (W)

NORTH

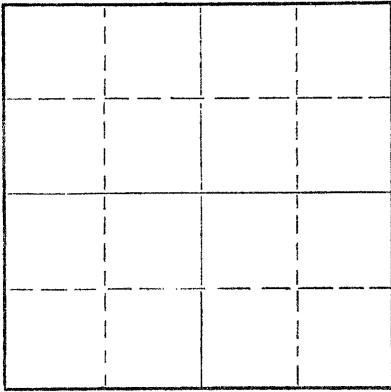

Locate well correctly on above
Section Plat

Location as "NE/CNW/SW" or footage from lines NE NE NW
Lease Owner Union Texas Petroleum
Lease Name Rehm Well No. 1
Office Address Drawer D, Great Bend, Kansas
Character of Well (completed as Oil, Gas or Dry Hole) Oil
Date well completed October 16, 19 59
Application for plugging filed May 11, 19 65
Application for plugging approved May 12, 19 65
Plugging commenced May 24, 19 65
Plugging completed May 27, 19 65
Reason for abandonment of well or producing formation Depleted

If a producing well is abandoned, date of last production December 28, 19 64
Was permission obtained from the Conservation Division or its agents before plugging was commenced? Yes

Name of Conservation Agent who supervised plugging of this well W. L. Nichols
Producing formation _____ Depth to top _____ Bottom _____ Total Depth of Well 3687 Feet
Show depth and thickness of all water, oil and gas formations.

OIL, GAS OR WATER RECORDS

CASING RECORD

FORMATION	CONTENT	FROM	TO	SIZE	PUT IN	PULLED OUT
				8 5/8"	197'	None
				4 1/2"	3723'	1971.11

Describe in detail the manner in which the well was plugged, indicating where the mud fluid was placed and the method or methods used in introducing it into the hole. If cement or other plugs were used, state the character of same and depth placed, from _____ feet to _____ feet for each plug set.

Plug set 3559'

3559 - 3530' Sand
3530 - 3494' 3 sacks cement
3494 - 600' 10 sacks Gelmud plug, one truck load from rotary pits
600 - 480' 20 sacks cement
480' - 150' 20 sacks cement
150 - 35' mud
35 - 30' rock bridge
30 - Base 10 sacks cement

RECEIVED
STATE CORPORATION COMMISSION

JUN 9 1965

6-9-65
CONSERVATION DIVISION
Wichita, Kansas

(If additional description is necessary, use BACK of this sheet)

Name of Plugging Contractor Santa Fe Pipe & Supply, Inc.
Address P. O. Box 562, Great Bend, Kansas

STATE OF KANSAS, COUNTY OF BARTON, ss.
Harold Rosenberg

(employee of owner) or (owner or operator) of the above-described well, being first duly sworn on oath, says: That I have knowledge of the facts, statements, and matters herein contained and the log of the above-described well as filed and that the same are true and correct. So help me God.

(Signature) Harold Rosenberg
Dip. Clerk
Drawer D, Great Bend, Kansas
(Address)

SUBSCRIBED AND SWORN TO before me this 8th day of June, 19 65

Esther L. Koch
Notary Public.

My commission expires Feb. 7, 1966

