


Give All Information Completely
Make Required Affidavit
Mail or Deliver Report to:
Conservation Division
State Corporation Commission
211 No. Broadway
Wichita, Kansas

WELL PLUGGING RECORD

Decatur County, Sec. 28 Twp. 2S Rge. 28W (E) (W)

Location as "NE/CNW/SW" or footage from lines SW SW SE
Lease Owner Sauvage Drilling Co., Inc.
Lease Name Beck Well No. 3
Office Address Oberlin, Kansas
Character of Well (completed as Oil, Gas or Dry Hole) Dry
Date well completed 4-28-60 19
Application for plugging filed 4-29-60 19
Application for plugging approved 4-29-60 19
Plugging commenced 4-29-60 19
Plugging completed 4-29-60 19
Reason for abandonment of well or producing formation Dry

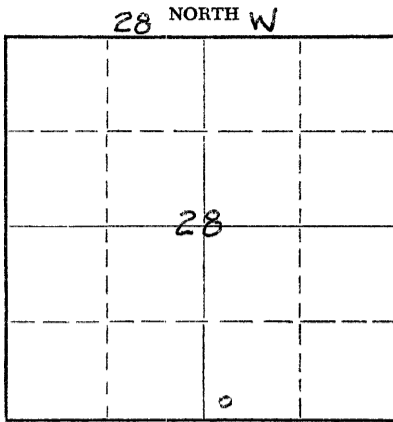

Locate well correctly on above Section Plat

If a producing well is abandoned, date of last production _____ 19____
Was permission obtained from the Conservation Division or its agents before plugging was commenced? yes

Name of Conservation Agent who supervised plugging of this well Al Fabricius - Hill City, Kansas
Producing formation _____ Depth to top _____ Bottom _____ Total Depth of Well 3753 Feet
Show depth and thickness of all water, oil and gas formations.

OIL, GAS OR WATER RECORDS

CASING RECORD

FORMATION	CONTENT	FROM	TO	SIZE	PUT IN	PULLED OUT
<u>Lime & sand</u>				<u>8-5/8"</u>	<u>170</u>	<u>none</u>

Describe in detail the manner in which the well was plugged, indicating where the mud fluid was placed and the method or methods used in introducing it into the hole. If cement or other plugs were used, state the character of same and depth placed, from _____ feet to _____ feet for each plug set.

Filled with heavy mud to 400 feet-set plug with 20 sax cement-filled with mud to 195 feet-plug with 20 sax cement- filled with mud to 40 feet-set plug with 10 sax cement and fill with mud to bottom of cellar

RECEIVED
STATE CORPORATION COMMISSION
MAY 23 1960
CONSERVATION DIVISION
Wichita, Kansas

(If additional description is necessary, use BACK of this sheet)
Name of Plugging Contractor Sauvage Drilling Co., Inc. 5-23-60
Address Oberlin, Kansas

STATE OF Kansas, COUNTY OF Decatur, ss.
Keith Gallatin (employee of owner) or (owner or operator) of the above-described well, being first duly sworn on oath, says: That I have knowledge of the facts, statements, and matters herein contained and the log of the above-described well as filed and that the same are true and correct. So help me God.

(Signature) Keith Gallatin
Keith Gallatin
Oberlin, Kansas
(Address)

SUBSCRIBED AND SWORN TO before me this 30 day of May, 1960

My commission expires June 18, 1962
Janice Bryan Notary Public.

