

STATE OF KANSAS
STATE CORPORATION COMMISSION


15-039-00014 00-00
WELL PLUGGING RECORD

OR
FORMATION PLUGGING RECORD

Give All Information Completely
Make Required Affidavit
Mail or Deliver Report to:
Conservation Division
State Corporation Commission
800 Biting Building
Wichita, Kansas

Strike out upper line
when reporting plug-
ging off formations.

Decatur County. Sec. 28 Twp. 2S Rge. (E) 28 (W)
Location as "NE $\frac{1}{4}$ NW $\frac{1}{4}$ SW $\frac{1}{4}$ " or footage from lines. C SE SE SW
Lease Owner. Helmerich & Payne, Inc.
Lease Name. C. G. Jorn Well No. 1
Office Address. 415 Philtower Building, Tulsa 3, Oklahoma
Character of Well (completed as Oil, Gas or Dry Hole). Dry Hole
Date well completed. 6-7-1946
Application for plugging filed. 6-18-1946
Application for plugging approved. 6-7-1946
Plugging commenced. 6-8-1946
Plugging completed. 6-9-1946
Reason for abandonment of well or producing formation. Dry hole

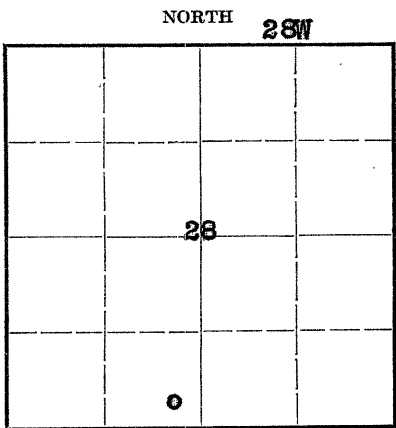

Locate well correctly on above
Section Plat

If a producing well is abandoned, date of last production. 19
Was permission obtained from the Conservation Division or its agents before plugging was com-
menced? Yes
Name of Conservation Agent who supervised plugging of this well. Mr. Kerr
Producing formation. Depth to top. Bottom. Total Depth of Well. 4165 Feet
Show depth and thickness of all water, oil and gas formations.

OIL, GAS OR WATER RECORDS

CASING RECORD

Formation	Content	From	To	Size	Put In	Pulled Out
Arbuckle - Top	Dry	4026		10-3/4"	158'	None
Regan "	"	4141				

Describe in detail the manner in which the well was plugged, indicating where the mud fluid was placed and the method or methods used in introducing it into the hold. If cement or other plugs were used, state the character of same and depth placed, from feet to feet for each plug set.

Hole mudded to 158' - bridged hole with rock and dumped 15 sacks of cement. Hole mudded to 25' - bridged hole with rock and dumped 10 sacks of cement to surface.

28 2 28W
57 43

(If additional description is necessary, use BACK of this sheet)

Correspondence regarding this well should be addressed to Helmerich & Payne, Inc.
Address. 415 Philtower Building, Tulsa 3, Oklahoma

STATE OF Oklahoma COUNTY OF Tulsa, ss.
Charles F. King (employee of owner) or (owner or operator) of the above-described well,
being first duly sworn on oath, says: That I have knowledge of the facts, statements, and matters herein contained and the log of the above-described well as filed and that the same are true and correct. So help me God.

(Signature) Charles F. King
415 Philtower Building, Tulsa 3, Oklahoma
(Address)

SUBSCRIBED AND SWORN to before me this 18th day of June 1946
Lee Griffin Notary Public.

My commission expires July 22, 1947.



6-21-46