

15-039-20315-00-00

STATE OF KANSAS
STATE CORPORATION COMMISSION


Form CP-4

Give All Information Completely
Make Required Affidavit
Mail or Deliver Report to:
Conservation Division
State Corporation Commission

WELL PLUGGING RECORD

P. O. Box 17027
Wichita, Kansas 67217
NORTH

Decatur County, Sec. 28 Twp. 2S Rge. 28 (W)

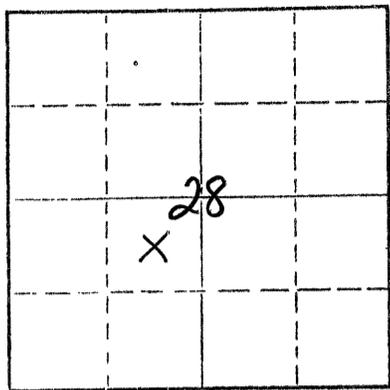

Locate well correctly on above
Section Plat

Location as "NE/CNW&SW" or footage from lines NE SW
Lease Owner Abercrombie Drilling, Inc.
Lease Name BRYANT Well No. #1
Office Address 801 Union Center, Wichita, Kansas
Character of Well (completed as Oil, Gas or Dry Hole) Dry Hole
Date well completed October 2, 19 75
Application for plugging filed October 2, 19 75
Application for plugging approved October 2, 19 75
Plugging commenced October 2, 19 75
Plugging completed October 2, 19 75
Reason for abandonment of well or producing formation No commercial quantity of oil or gas encountered.
If a producing well is abandoned, date of last production 19
Was permission obtained from the Conservation Division or its agents before plugging was commenced? Yes

Name of Conservation Agent who supervised plugging of this well Gilbert Balthazor
Producing formation _____ Depth to top _____ Bottom _____ Total Depth of Well 3719' Feet
Show depth and thickness of all water, oil and gas formations.

OIL, GAS OR WATER RECORDS CASING RECORD

FORMATION	CONTENT	FROM	TO	SIZE	PUT IN	PULLED OUT
				8 5/8"	205'	None

Describe in detail the manner in which the well was plugged, indicating where the mud fluid was placed and the method or methods used in introducing it into the hole. If cement or other plugs were used, state the character of same and depth placed, from _____ feet to _____ feet for each plug set.

1st Plug Set @ 1400' with 70 sx. cement
2nd Plug Set @ 200' with 20 sx. cement
3rd Plug Set @ 40' with 10 sx. cement
Plug was down @ 4:30 a.m. October 2, 1975

RECEIVED
STATE CORPORATION COMMISSION

OCT 6 1975 10-6-75

CONSERVATION DIVISION
Wichita, Kansas

(If additional description is necessary, use BACK of this sheet)
Name of Plugging Contractor Abercrombie Drilling, Inc.
Address 801 Union Center, Wichita, Kansas 67202

STATE OF KANSAS, COUNTY OF SEDGWICK, ss.
Jack L. Partridge-Asst. Sec. Treas. (employee of owner) or (owner or operator) of the above-described well, being first duly sworn on oath, says: That I have knowledge of the facts, statements, and matters herein contained and the log of the above-described well as filed and that the same are true and correct. So help me God.

(Signature) Jack L. Partridge
801 Union Center, Wichita, Kansas 67202
(Address)

Subscribed and sworn to before me this 3rd day of October, 19 75



July 21, 1979
Margo Dee Montgomery
Notary Public.