

15-039-00546-00-00


STATE OF KANSAS
STATE CORPORATION COMMISSION

Form CP-4

Give All Information Completely
Make Required Affidavit
Mail or Deliver Report to:
Conservation Division
State Corporation Commission
212 No. Market
Wichita, Kansas 67202

WELL PLUGGING RECORD

Decatur County, Sec. 28 Twp. 2 Rge. 28 (E) W (W)
Location as "NE/CNW/SW" or footage from lines NE SE SE
Lease Owner Donald C. Slawson
Lease Name Beck Well No. # 1
Office Address 408 One Twenty Bldg.; Wichita, Kans. 67202
Character of Well (completed as Oil, Gas or Dry Hole) _____
Date well completed _____ 19____
Application for plugging filed July 19 71
Application for plugging approved July 19 71
Plugging commenced August 7 19 71
Plugging completed August 9 19 71
Reason for abandonment of well or producing formation _____

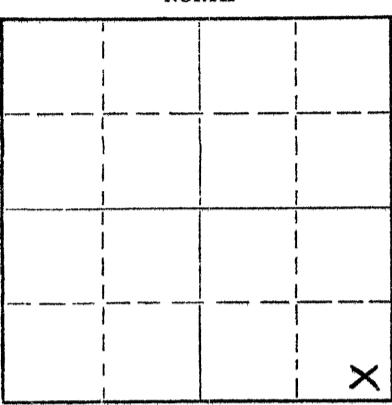

Locate well correctly on above
Section Plat

If a producing well is abandoned, date of last production _____ 19____
Was permission obtained from the Conservation Division or its agents before plugging was commenced? Yes

Name of Conservation Agent who supervised plugging of this well Leo Massey
Producing formation _____ Depth to top _____ Bottom _____ Total Depth of Well _____ Feet
Show depth and thickness of all water, oil and gas formations.

OIL, GAS OR WATER RECORDS

CASING RECORD

FORMATION	CONTENT	FROM	TO	SIZE	PUT IN	PULLED OUT
				8 5/8	182	None
				5 1/2	3775	1587

Describe in detail the manner in which the well was plugged, indicating where the mud fluid was placed and the method or methods used in introducing it into the hole. If cement or other plugs were used, state the character of same and depth placed, from _____ feet to _____ feet for each plug set.

August 7, 1971 Plugged off bottom. Dumped sand to 3650'. Mixed and dumped 5 sx cement.
August 9, 1971 Plugged off top. Allied Cementing Co. mixed and pumped down 8 5/8" surface casing: 5 hulls, 13 gel, 100 cement, 12 gel, 25 cement, 5 gel and 10 sx cement.

RECEIVED
STATE CORPORATION COMMISSION
AUG 25 1971
CONSERVATION DIVISION
Wichita, Kansas

8-25-71

(If additional description is necessary, use BACK of this sheet)

Name of Plugging Contractor RUSS CASING PULLING, INC.
Address P. O. Box 1082 Great Bend, Kansas 67530

STATE OF Kansas, COUNTY OF Sedgewick, ss.

(employee of owner) or (owner or operator) of the above-described well, being first duly sworn on oath, says: That I have knowledge of the facts, statements, and matters herein contained and the log of the above-described well as filed and that the same are true and correct. So help me God.

(Signature) James C. Remsburg
408-120 Bldg. Wichita 67202
(Address)

Subscribed and Sworn to before me this 25th day of August, 19 71
January 17, 1973
My commission expires _____

Mary Lou Taylor
Notary Public.

