

CARD MUST BE TYPED

State of Kansas  
**NOTICE OF INTENTION TO DRILL**  
(see rules on reverse side)

CARD MUST BE SIGNED

Starting Date: October, 16, 1984  
month day year

API Number 15- 039-20,751-0000

OPERATOR: License # 6860  
S & W Drilling Co., Inc

NW/4 NW/4 ... Sec 33.. Twp 2S.. S, Rge 29W.  East  West  
(location)

Name

Address P. O. Box 132

City/State/Zip Oberlin, Ks. 67749

Contact Person James L. Reeves

Phone 913-475-3325

4620 ..... Ft North from Southeast Corner of Section  
4620 ..... Ft West from Southeast Corner of Section  
(Note: Locate well on Section Plat on reverse side)

CONTRACTOR: License # 6033

Name Murfin Drilling Co.

City/State Wichita, Ks.

Nearest lease or unit boundary line 6.60 ..... feet.  
County Decatur

Lease Name Scott Well# 33-4

Domestic well within 330 feet:  yes  no

Municipal well within one mile:  yes  no

Well Drilled For: Well Class: Type Equipment:

- |   |                               |   |  |
|---|-------------------------------|---|--|
| <input checked="" type="checkbox"/> Oil | <input type="checkbox"/> Swd  | <input type="checkbox"/> Infield              | <input checked="" type="checkbox"/> Mud Rotary |
| <input type="checkbox"/> Gas            | <input type="checkbox"/> Inj  | <input checked="" type="checkbox"/> Pool Ext. | <input type="checkbox"/> Air Rotary            |
| <input type="checkbox"/> OWWO           | <input type="checkbox"/> Expl | <input type="checkbox"/> Wildcat              | <input type="checkbox"/> Cable                 |

Depth to Bottom of fresh water ..... 100 ..... feet

Lowest usable water formation ..... ~~Dakota~~ *Unconsolidated* .....

Depth to Bottom of usable water ..... ~~1700~~ *1200* ..... feet

Surface pipe by Alternate: ~~1 1/2"~~ *2"*

Surface pipe to be set ..... 250 ..... feet

Conductor pipe if any required ..... none ..... feet

Ground surface elevation ..... 2750 est. .... feet MSL

This Authorization Expires ..... 4-11-85 .....

Approved By ..... 10-11-84 *R* .....

If OWWO: old well info as follows:

Operator .....

Well Name .....

Comp Date ..... Old Total Depth .....

Projected Total Depth ..... 4050 ..... feet

Projected Formation at TD ..... Base KC .....

Expected Producing Formations ..... KC .....

I certify that we will comply with K.S.A. 55-101, et seq., plus eventually plugging hole to K.C.C. specifications.

Date 10-10-84 Signature of Operator or Agent


*Tand L Reed*

Title *Consultant*

Must be filed with the K.C.C. five (5) days prior to commencing well  
 This card void if drilling not started within six (6) months of date received by K.C.C.

**Important procedures to follow :**

**A Regular Section of Land**  
**1 Mile = 5,280 Ft.**

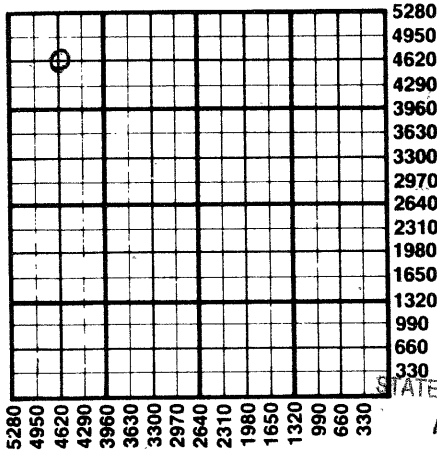

1. Notify District office before setting surface casing.
2. Set surface casing by circulating cement to the top.
3. File completion forms ACO-1 with K.C.C. within 90 days of well completion, following instructions on ACO-1, side 1, and including copies of wireline logs.
4. Notify District office 48 hours prior to old well workover or re-entry.
5. Prior to plugging, prepare a plugging plan, then obtain agreement from the appropriate district office for an approved plugging plan.
6. Submit plugging report (CP-4) to K.C.C. after plugging is completed.
7. Obtain an approved injection docket number before disposing of salt water.
8. Notify K.C.C. within 10 days when injection commences or terminates.
9. If an alternate 2 completion, cement in the production pipe from below any usable water to surface within 120 days of spud date.

RECEIVED  
 STATE CORPORATION COMMISSION

10-11-84  
 OCT 11 1984

CONSERVATION DIVISION  
 Wichita, Kansas

State Corporation Commission of Kansas  
 Conservation Division  
 200 Colorado Derby Building  
 Wichita, Kansas 67202  
 (316) 263-3238