


15-039-00155-00-01

FORM CP-4

STATE OF KANSAS  
STATE CORPORATION COMMISSION  
CONSERVATION DIVISION  
P. O. BOX 17027  
WICHITA, KANSAS 67217

WELL PLUGGING RECORD

Decatur County. Sec. 2 Twp. 2 Rge. 30 ~~XX~~ (W)  
Location as "NE/CNW&SW&" or footage from lines SE SE NW

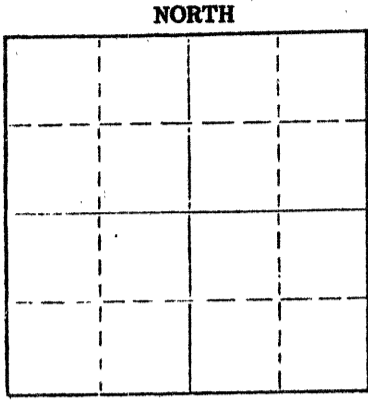

Locate well correctly on above Section Plot

Lease Owner John P. Jennings  
Lease Name Weber Well No. 1  
Office Address 200 E. 1st Street, Suite 309  
Character of Well (completed as Oil, Gas or Dry Hole) Oil  
Date well completed July 24 19 74  
Application for plugging filed October 1 19 74  
Application for plugging approved October 5 19 74  
Plugging commenced October 28 19 74  
Plugging completed February 16 19 75  
Reason for abandonment of well or producing formation  
Non-commercial oil production - no oil sold  
If a producing well is abandoned, date of last production Sept. 15 19 74  
Was permission obtained from the Conservation Division or its agents before plugging was commenced? Yes

Name of Conservation Agent who supervised plugging of this well Balthazar  
Producing formation Kansas City Depth to top 3640 Bottom 3870 Total Depth of Well 3960 Feet  
Show depth and thickness of all water, oil and gas formations.


OIL, GAS OR WATER RECORDS

CASING RECORD

FORMATION	CONTENT	FROM	TO	SIZE	PUT IN	PULLED OUT
Kansas City	Oil & Water	3802	3808	2-7/8"	3860'	1540'

Describe in detail the manner in which the well was plugged, indicating where the mud fluid was placed and the method or methods used in introducing it into the hole. If cement or other plugs were used, state the character of same and depth placed, from \_\_\_\_\_ feet to \_\_\_\_\_ feet for each plug set.

Pumped down 8-5/8  
3 sx. Hulls  
4 sx. Gel  
80 sx. cem. 50/50 poz mix 6% Gel.  
26 sx. Gel  
Released plug  
45 sx. cem. 50/50 poz mix 6% Gel.

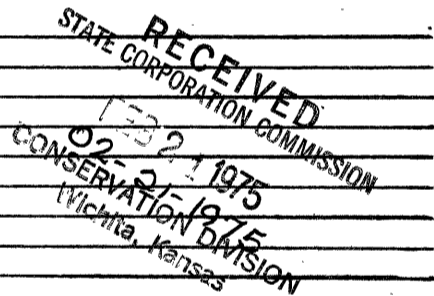


(If additional description is necessary, use BACK of this sheet)  
Name of Plugging Contractor Pfeifer Well Service  
Address Box 386 Hill City, Kansas

STATE OF KANSAS COUNTY OF SEDGWICK  
John P. Jennings (employee of owner) or (owner or operator) of the above-described well, being first duly sworn on oath, says: That I have knowledge of the facts, statements, and matters herein contained and the log of the above-described well as filed and that the same are true and correct. So help me God.

(Signature) *John P. Jennings*

Subscribed and sworn to before me this 20th day of February, 1975.

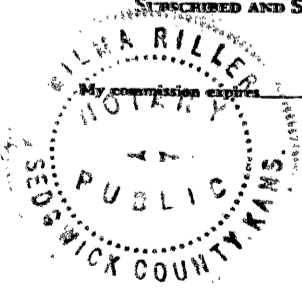

July 27, 1975.  
Wilma Riller  
Notary Public.