

STATE OF KANSAS
STATE CORPORATION COMMISSION

15-039-20492-00-00
WELL PLUGGING RECORD

Give All Information Completely
Make Required Affidavit
Mail or Deliver Report to
Conservation Division
State Corporation Comm.
245 North Water
Wichita, KS 67202


Decatur County, Sec. 3 Twp. 2 Rge. 30 E/W
Location as "NE/CNW $\frac{1}{4}$ SW $\frac{1}{4}$ " or footage from lines
SE SE SE

Lease Owner D/FW Oil & Gas
Lease Name FORTIN Well No. 1
Office Address 6440 N. Central Expy. #603, Dallas, TX 75206
Character of Well (Completed as Oil, Gas or Dry Hole)

Dry Hole
Date Well completed May 8 1980
Application for plugging filed (Verbally) May 8 1980
Application for plugging approved (Verbally) May 8 1980
Plugging commenced May 8 1980
Plugging completed May 8 1980

Reason for abandonment of well or producing formation
No commercial quantity of oil or gas encountered
If a producing well is abandoned, date of last production 19

Was permission obtained from the Conservation Division or its agents before plugging was commenced? Yes

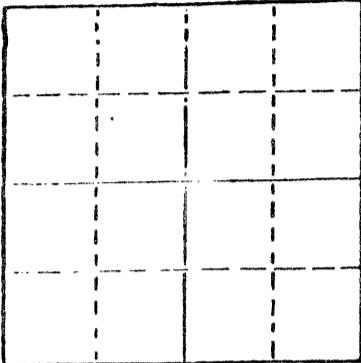

Locate well correctly on above Section Plot

Name of Conservation Agent who supervised plugging of this well
Producing formation Depth to top Bottom Total Depth of Well
Show depth and thickness of all water, oil and gas formations.

OIL, GAS OR WATER RECORDS				CASING RECORD		
FORMATION	CONTENT	FROM	TO	SIZE	PUT IN	PULLED OUT

Describe in detail the manner in which the well was plugged, indicating where the mud fluid was placed and the method or methods used in introducing it into the hold. If cement or other plugs were used, state the character of same and depth placed, from feet to feet for each plug set.

Set 1st plug at 1450' with 70 sacks,
2nd plug at 340' with 20 sacks,
3rd plug 40' solid bridge with 10 sacks,
and rathole with 5 sacks.

Plug was down at 9:30 a.m., 5-8-80.

(If additional description is necessary, use BACK of this sheet)

Name of Plugging Contractor Abercrombie Drilling, Inc.


STATE OF Kansas COUNTY OF Sedgwick
Jack L. Partridge, Asst. Sec.-Treas. (employee of owner or owner or operator)
of the above-described well, being first duly sworn on oath, says: That I have knowledge of the facts, statements, and matters herein contained and the log of the above described well as filed and that the same are true and correct. So help me God.

(Signature) Jack L. Partridge
801 Union Center, Wichita, Kansas 67202
(Address)

SUBSCRIBED AND SWORN TO before me this 19th day of May, 1980

My commission expires

Sherrie L. Brooks Notary Public.

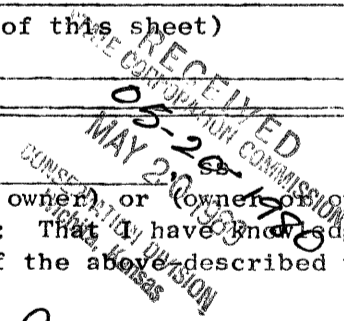

CONTRACTOR'S WELL LOG

15-039-20 492-00-00

OPERATOR: D/FW Oil & Gas
 CONTRACTOR: Abercrombie Drilling, Inc.
 WELL NAME: FORTIN #1
 LOCATION: SE SE SE, Section 3-2-30,
 Decatur County, Kansas
 SPUD DATE: 5-2-80
 COMPLETION DATE: 5-8-80

0	230	Surface clay & Shale
230	2489	Shale
2489	2508	Anhydrite
2508	3110	Shale
3110	3586	Lime & Shale
3586	4100	Lime
	4100	Rotary Total Depth

Spud hole at 12:00 noon, 5-2-80. Drilled 361' of 12-1/4" hole. Ran 9 joints of 8-5/8" 20# casing (Tally 353.58). Set @ 355.50' with 300 sacks of common cement, 2% gel, 3% Ca.Cl. Cement did circ. Plug was down at 7:00 p.m., 5-2-80.

T.D. 4100'. Set 1st plug at 1450' with 70 sacks, 2nd plug at 340' with 20 sacks, 3rd plug 40' solid bridge with 10 sacks, and rathole with 5 sacks. 50/50 posmix, 6% gel. Plug was down at 9:30 a.m., 5-8-80. State Plugger - Gilbert Balthazor.

SAMPLE TOPS:

Anhydrite 2477'
 B/Anhydrite 2508'

STATE OF KANSAS)
) SS
 COUNTY OF SEDGWICK)

Jack L. Partridge, Assistant Secretary-Treasurer of Abercrombie Drilling, Inc., does hereby state that the above and foregoing is a true and correct copy of the log of the FORTIN #1, SE SE SE, Section 3-2-30, Decatur County, Kansas.

ABERCROMBIE DRILLING, INC.

BY: Jack L. Partridge
 Jack L. Partridge, Asst. Sec.-Treas.

Subscribed and sworn to before me, a Notary Public, in and for the aforesaid county and state as of this 19th day of May, 1980.

Sherrie L. Brooks, Notary Public

