


15-039-00453-00-00

Give All Information Completely
Make Required Affidavit
Mail or Deliver Report to:
Conservation Division
State Corporation Commission
212 North Market, Insurance Bldg.
Wichita, Kansas

WELL PLUGGING RECORD

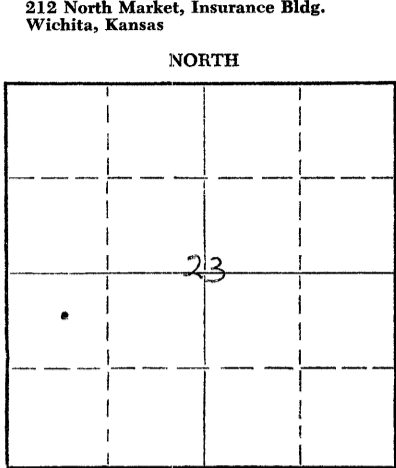

Locate well correctly on above Section Plat

Decatur County. Sec. 23 Twp. 2S Rge. (E) 30 (W)
Location as "NE/CNW/SW" or footage from lines 150' E/C NW - SW
Lease Owner Halliburton Oil Producing Company
Lease Name May Well No. 1
Office Address 520 Cameron Bldg. Okla. City 6, Oklahoma
Character of Well (completed as Oil, Gas or Dry Hole) Dry Hole
Date well completed January 9 1963
Application for plugging filed Verbal January 9 1963
Application for plugging approved January 9 1963
Plugging commenced January 9 1963
Plugging completed January 9 1963
Reason for abandonment of well or producing formation Dry Hole

If a producing well is abandoned, date of last production ----- 19
Was permission obtained from the Conservation Division or its agents before plugging was commenced? Yes

Name of Conservation Agent who supervised plugging of this well Mr. W.L. Nichols
Producing formation None Depth to top ----- Bottom ----- Total Depth of Well 4092 Feet
Show depth and thickness of all water, oil and gas formations.

OIL, GAS OR WATER RECORDS

CASING RECORD

FORMATION	CONTENT	FROM	TO	SIZE	PUT IN	PULLED OUT
<u>Iansing</u>	<u>Not Commercial</u>	<u>3842</u>	<u>TD</u>	<u>85/8</u>	<u>288'</u>	<u>0</u>

Describe in detail the manner in which the well was plugged, indicating where the mud fluid was placed and the method or methods used in introducing it into the hole. If cement or other plugs were used, state the character of same and depth placed, from ----- feet to ----- feet for each plug set.

Hole filled with heavy mud T.D. to 540'
Put 20 sack cement plug at 540' to 475'
Filled hole with heavy mud to 240' to 180'
Put 20 sack cement plug at 240' inside 8 5/8" casing
Filled hole with heavy mud to 40'
Put 10 sack cement plug 40' to 10'
Cut off casing below ground level

RECEIVED
STATE CORPORATION COMMISSION

JAN 29 1963
1-29-63
CONSERVATION DIVISION
Wichita, Kansas

(If additional description is necessary, use BACK of this sheet)

Name of Plugging Contractor Burch Drilling Company
Address 1011 Union Center Wichita, Kansas

STATE OF Oklahoma, COUNTY OF Oklahoma, ss.
D.D. Swearingen (employee of owner) or (owner or operator) of the above-described well, being first duly sworn on oath, says: That I have knowledge of the facts, statements, and matters herein contained and the log of the above-described well as filed and that the same are true and correct. So help me God.

(Signature) D.D. Swearingen
520 Cameron Bldg. Okla. City 6, Oklahoma
(Address)

SUBSCRIBED AND SWORN TO before me this 22nd day of January, 1963

My commission expires 4-15-66

Marysue Lamberley
Notary Public.

