

STATE OF KANSAS
 STATE CORPORATION COMMISSION
 200 Colorado Derby Bldg.
 Wichita, Kansas 67202


Form CP-4
 Rev. 12-15-80

15-039-20522-00-00

WELL PLUGGING RECORD

Give All Information Completely
 Make Required Affidavit

COUNTY Decatur SEC. 22 TWP. 2-S RGE. 30-W E/W
 Location as in quarters or footage from lines:
 C/SE/NE

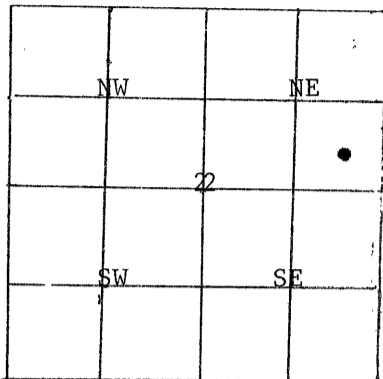

Locate Well
 correctly on above
 Section Platt.

Lease Owner Cherokee Petroleum Corp.
 Lease Name Anderson #1 Well No. 1
 Office Address 410 17th, Suite 2300 Denver, CO 80202
 Character of Well (Completed as Oil, Gas or Dry Hole): Oil
 Date Well Completed November 5, 1980
 Application for plugging filed May 12, 1982
 Plugging commenced June 11, 1982
 Plugging completed July 19, 1982
 Reason for abandonment of well or producing formation
Well failed to produce hydrocarbon shows in paying quantities
 Was permission obtained from the Conservation Division or it's
 Agent's before plugging was commenced? Yes

Name of Conservation Agent who supervised plugging of this well Carl Goodrow
 Producing formation LKC Depth to top 3856 bottom 59 T.D. 4100'
 Show depth and thickness of all water, oil and gas formations.

OIL, GAS OR WATER RECORDS

Casing Record

Formation	Content	From	To	Size	Put in	Pulled Out
LKC	Oil/H2O	3856	59	8 5/8	259'	
D-zone	Oil/H2O	3873	76	4 1/2"	4100'	1221.32'
F-zone	Oil/H2O	4044	50			

Describe in detail the manner in which the well was plugged, indicating where the mud fluid was placed and the method or methods used in introducing it into the hold. If cement or other plugs were used, state the character of same and depth placed, from _____ feet to _____ feet for each plug set. Sanded from 4100' to 3734' / 5 sks. cement.

Plugging procedures- 4 sks. hulls, 20 sks gel., 70 sks. cement, 20 sks. gel, 60 sks. cement - plug 8 5/8/10 sks. cement (all cement 50/50 pos., 4% gel., 3%CC)

(If additional description is necessary, use BACK of this sheet)

Name of Plugging Contractor Halliburton Co. and Oil Field Service and Supply, Inc.

STATE OF KANSAS COUNTY OF DECATUR, ss.

James R. Betts, operator (employee of owner) or (owner or operator) of the above-described well, being first duly sworn on oath, says: That I have knowledge of the facts, statements, and matters herein contained and the log of the above-described well as filed and that the same are true and correct. So help me God.

(Signature) James R. Betts
 James R. Betts
 (Address)
 P.O. Drawer 298 Oberlin, KS 67749

SUBSCRIBED AND SWORN TO before me this 20th day of July, 19 82

My Commission expires: December 4, 1985

Rhonda Salem
 Rhonda Salem
 Notary Public.

RECEIVED
 STATE CORPORATION COMMISSION
 JUL 22 1982
 7-22-82
 CONSERVATION DIVISION
 Wichita, Kansas

