

15-039-00149-00-00


STATE OF KANSAS  
STATE CORPORATION COMMISSION

Give All Information Completely  
Make Required Affidavit  
Mail or Deliver Report to:  
Conservation Division  
State Corporation Commission  
211 No. Broadway  
Wichita, Kansas

WELL PLUGGING RECORD

Decatur County. Sec. 21 Twp. 2S Rge. 30W (E) (W)

Location as "NE/CNW/SW" or footage from lines SW SW NE  
Lease Owner M. J. Lebsack  
Lease Name Helmkamp "A" Well No. 1  
Office Address 502 Kittridge Bldg., Denver, Colorado  
Character of Well (completed as Oil, Gas or Dry Hole) Dry Hole  
Date well completed 6-20-59 19  
Application for plugging filed 6-20-59 19  
Application for plugging approved 6-20-59 19  
Plugging commenced 6-20-59 19  
Plugging completed 6-20-59 19  
Reason for abandonment of well or producing formation Dry Hole

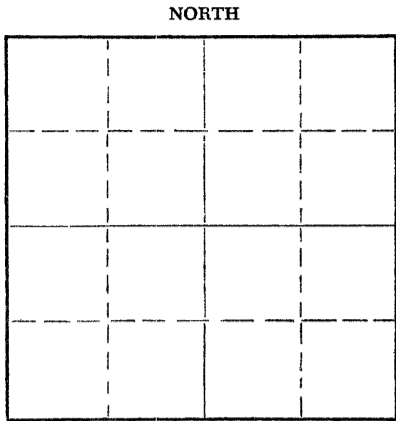

Locate well correctly on above Section Plat

If a producing well is abandoned, date of last production 19  
Was permission obtained from the Conservation Division or its agents before plugging was commenced? Yes

Name of Conservation Agent who supervised plugging of this well A. D. Fabricius  
Producing formation Depth to top Bottom Total Depth of Well 4392 Feet  
Show depth and thickness of all water, oil and gas formations.

OIL, GAS OR WATER RECORDS

CASING RECORD

FORMATION	CONTENT	FROM	TO	SIZE	PUT IN	PULLED OUT
				8 5/8"	255'	

Describe in detail the manner in which the well was plugged, indicating where the mud fluid was placed and the method or methods used in introducing it into the hole. If cement or other plugs were used, state the character of same and depth placed, from feet to feet for each plug set.

1st plug @ 600' w/ 20 sx. cement  
2nd plug @ 245' w/ 20 sx. cement  
Top plug @ 40' w/ 10 sx. cement

RECEIVED  
STATE CORPORATION COMMISSION  
JUL 17 1959  
7-10-59

(If additional description is necessary, use BACK of this sheet)  
Name of Plugging Contractor Leben Drilling, Inc.  
Address 905 Central Bldg., Wichita, Kansas

STATE OF KANSAS, COUNTY OF SEDGWICK, ss.  
Frank Hamlin (employee of owner) or (owner or operator) of the above-described well, being first duly sworn on oath, says: That I have knowledge of the facts, statements, and matters herein contained and the log of the above-described well as filed and that the same are true and correct. So help me God.

(Signature) Frank Hamlin  
905 Central Bldg., Wichita, Kansas (Address)

SUBSCRIBED AND SWORN TO before me this 9th day of July, 19 59

My commission expires April 23, 1963  
Juanita M. Green Notary Public

PLUGGING  
FILE SEC. 21 T. 2 R. 30W  
BOOK PAGE 50 LINE 9