

15-039-20286-00-00

STATE OF KANSAS
STATE CORPORATION COMMISSION


Form CP-4

Give All Information Completely
Make Required Affidavit
Mail or Deliver Report to:
Conservation Division
State Corporation Commission
P. O. Box 17027
Wichita, Kansas 67217
NORTH

WELL PLUGGING RECORD

Decatur County, Sec 25 Twp. 2S Rge. (E) 30 (W)

Location as "NE/CNW/SE/SW" or footage from lines 150' NW C SE SE
Lease Owner Wilton C. Jackson
Lease Name UNGER
Office Address 8 North First Street, Myssa, Oregon Well No. #1 97913
Character of Well (completed as Oil, Gas or Dry Hole) Dry Hole
Date well completed June 11 1974
Application for plugging filed (verbal) June 11 1974
Application for plugging approved (verbal) June 11 1974
Plugging commenced June 11 1974
Plugging completed June 11 1974
Reason for abandonment of well or producing formation

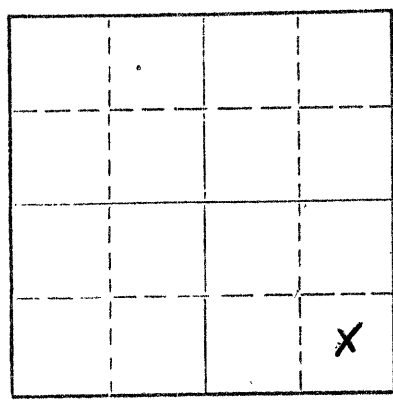

Locate well correctly on above Section Plat

If a producing well is abandoned, date of last production 19
Was permission obtained from the Conservation Division or its agents before plugging was commenced? Yes

Name of Conservation Agent who supervised plugging of this well Bill Nichols
Producing formation Depth to top Bottom Total Depth of Well 3855' Feet
Show depth and thickness of all water, oil and gas formations.

OIL, GAS OR WATER RECORDS

CASING RECORD

FORMATION	CONTENT	FROM	TO	SIZE	PUT IN	PULLED OUT
				8 5/8"	222'	None

Describe in detail the manner in which the well was plugged, indicating where the mud fluid was placed and the method or methods used in introducing it into the hole. If cement or other plugs were used, state the character of same and depth placed, from feet to feet for each plug set.

1st Plug Set @ 1500' w/110 cu. ft. cement
2nd Plug Set @ 215' w/30 cu. ft. cement
3rd Plug Set @ 40' w/10 cu. ft. cement

RECEIVED
STATE CORPORATION COMMISSION
JUN 13 1974
CONSERVATION DIVISION
Wichita, Kansas
6-13-74

(If additional description is necessary, use BACK of this sheet)
Name of Plugging Contractor Abercrombie Drilling, Inc.
Address 801 Union Center, Wichita, Kansas 67202

STATE OF KANSAS, COUNTY OF SEDGWICK, ss.
Jerry A. Langrehr (employee of owner) or (owner or operator) of the above-described

well, being first duly sworn on oath, says: That I have knowledge of the facts, statements, and matters herein contained and the log of the above-described well as filed and that the same are true and correct. So help me God.

(Signature) Jerry A. Langrehr
801 Union Center, Wichita, Kansas 67202
(Address)

SUBSCRIBED AND SWORN TO before me this 12th day of June, 1974

Nancy E. Bledsoe
Nancy E. Bledsoe Notary Public.

My commission expires April 8, 1978