

15-039-00465-06-00

STATE OF KANSAS  
STATE CORPORATION COMMISSION

Form CP-4

WELL PLUGGING RECORD

Give All Information Completely  
Make Required Affidavit  
Mail or Deliver Report to:  
Conservation Division  
State Corporation Commission  
211 No. Broadway  
Wichita, Kansas

Decatur County, Sec. 25 Twp. 2S Rge. (E) 30 (W)

Location as "NE/CNW/SW" or footage from lines C SE SE

Lease Owner Rains & Williamson Oil Co.

Lease Name UNGER Well No. 2

Office Address 412 Union Center - Wichita 2, Kansas

Character of Well (completed as Oil, Gas or Dry Hole) Dry Hole

Date well completed January 22 19 63

Application for plugging filed January 22 19 63

Application for plugging approved January 22 19 63


Plugging commenced January 22 19 63

Plugging completed January 22 19 63

Reason for abandonment of well or producing formation No oil or gas found in commercial quantities.

If a producing well is abandoned, date of last production ----- 19 --

Was permission obtained from the Conservation Division or its agents before plugging was commenced? Yes

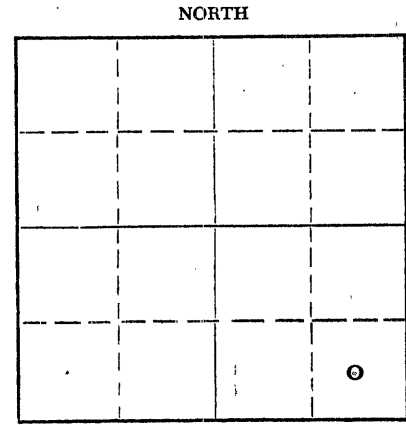

Locate well correctly on above Section Plat

Name of Conservation Agent who supervised plugging of this well Mr. Bill Nichols, Marland, Kansas

Producing formation None Depth to top --- Bottom --- Total Depth of Well 4037 Feet

Show depth and thickness of all water, oil and gas formations.

OIL, GAS OR WATER RECORDS

CASING RECORD

FORMATION	CONTENT	FROM	TO	SIZE	PUT IN	PULLED OUT
				8-5/8"	211'	None

Describe in detail the manner in which the well was plugged, indicating where the mud fluid was placed and the method or methods used in introducing it into the hole. If cement or other plugs were used, state the character of same and depth placed, from \_\_\_\_\_ feet to \_\_\_\_\_ feet for each plug set.

Set first plug at 540'. Cemented through drill pipe with 20 sacks cement. Filled hole with rotary mud to 180', set second plug. Cemented through drill pipe with 20 sacks cement. Filled hole with rotary mud to 40 feet of base of cellar. Set plug and hulls and capped with 10 sacks cement.

RECEIVED  
STATE CORPORATION COMMISSION

JAN 25 1963

1-25-63

CONSERVATION DIVISION  
Wichita, Kansas

(If additional description is necessary, use BACK of this sheet)

Name of Plugging Contractor Rains & Williamson Oil Co.

Address 412 Union Center - Wichita, Kansas

STATE OF KANSAS, COUNTY OF SEDGWICK, ss.

Wilson Rains - Partner (employee of owner) or (owner or operator) of the above-described

well, being first duly sworn on oath, says: That I have knowledge of the facts, statements, and matters herein contained and the log of the above-described well as filed and that the same are true and correct. So help me God.

(Signature) Wilson Rains Wilson Rains  
412 Union Center - Wichita, Kansas

(Address)

SUBSCRIBED AND SWORN TO before me this 24th day of January, 19 63

My commission expires November 8, 1966

Sherry Gish Notary Public.

