


15-039-00464-00-00

WELL PLUGGING RECORD

Give All Information Completely  
Make Required Affidavit  
Mail or Deliver Report to:  
Conservation Division  
State Corporation Commission  
211 No. Broadway  
Wichita, Kansas

Decatur County, Sec. 25 Twp. 2S Rge. 30 W (E) (W)

Location as "NE/CNW/SW" or footage from lines C SW NE  
Lease Owner Rains & Williamson Oil Co.  
Lease Name Barker Well No. 1  
Office Address 412 Union Center, Wichita 2, Kansas  
Character of Well (completed as Oil, Gas or Dry Hole) Dry Hole  
Date well completed 12-12 19 62  
Application for plugging filed 12-12 19 62  
Application for plugging approved 12-12 19 62  
Plugging commenced 12-12 19 62  
Plugging completed 12-12 19  
Reason for abandonment of well or producing formation No oil or gas found in commercial quantities  
If a producing well is abandoned, date of last production -- 19  
Was permission obtained from the Conservation Division or its agents before plugging was commenced? Yes

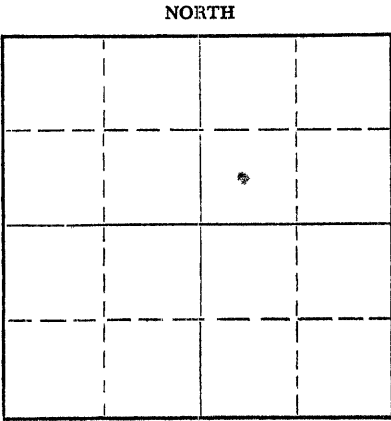

Locate well correctly on above Section Plat

Name of Conservation Agent who supervised plugging of this well Eldon Petty, Hays, Kansas  
Producing formation None Depth to top Bottom Total Depth of Well 4053 Feet  
Show depth and thickness of all water, oil and gas formations.

OIL, GAS OR WATER RECORDS

CASING RECORD

FORMATION	CONTENT	FROM	TO	SIZE	PUT IN	PULLED OUT
				8-5/8"	256'	None

Describe in detail the manner in which the well was plugged, indicating where the mud fluid was placed and the method or methods used in introducing it into the hole. If cement or other plugs were used, state the character of same and depth placed, from feet to feet for each plug set.

Filled hole to 550' with rotary mud. Set plug and cement with 20 sacks cement through drill pipe. Fill hole to 240' with rotary mud. Set plug and cement with 20 sacks cement through drill pipe. Fill hole to 35' of base of cellar. Set plug and cap with 10 sacks cement.

RECEIVED  
STATE CORPORATION COMMISSION

DEC 18 1962

12-18-62  
CONSERVATION DIVISION  
Wichita, Kansas

(If additional description is necessary, use BACK of this sheet)

Name of Plugging Contractor Rains & Williamson Oil Co.  
Address 412 Union Center, Wichita 2, Kansas

STATE OF KANSAS, COUNTY OF SEDGWICK, ss.  
Wilson Rains - Partner

(owner or operator) of the above-described well, being first duly sworn on oath, says: That I have knowledge of the facts, statements, and matters herein contained and the log of the above-described well as filed and that the same are true and correct. So help me God.

(Signature) Wilson Rains  
Wilson Rains  
412 Union Center - Wichita 2, Kansas  
(Address)

SUBSCRIBED AND SWORN TO before me this 17th day of December, 19 62

My commission expires November 8, 1966

Sherry Gish  
Sherry Gish Notary Public.

