


15-689-20013-00-00

WELL PLUGGING RECORD

Give All Information Completely
 Make Required Affidavit

COUNTY Decatur SEC. 14 TWP. 2S RGE. 30 ~~XX~~W
 Location as in quarters or footage from lines:
C NW NW SE

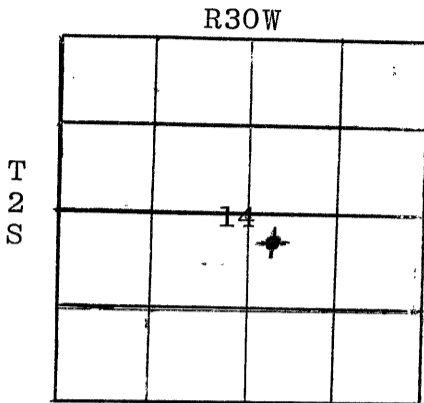

Locate Well
 correctly on above
 Section Platt.

Lease Owner Halliburton Oil Producing Co. (Operator #5988)
 Lease Name Mines Well No. 1
 Office Address 2915 Classen Blvd., Okla. City, OK 73106
 Character of Well (Completed as Oil, Gas or Dry Hole): Oil
 Date Well Completed June 20, 1967
 Application for plugging filed January 5, 1983
 Plugging commenced January 25, 1983
 Plugging completed January 25, 1983
 Reason for abandonment of well or producing formation _____

Depleted

Was permission obtained from the Conservation Division or it's
 Agent's before plugging was commenced? Yes

Name of Conservation Agent who supervised plugging of this well Carl Goodrow

Producing formation K.C. Lansing Depth to top 3962' bottom 3966' T.D. 4050'

Show depth and thickness of all water, oil and gas formations.

OIL, GAS OR WATER RECORDS

Casing Record

Formation	Content	From	To	Size	Put in	Pulled Out
Howard	Water	3506'	3580'	7"	320'	0
Topeka	Water	3645'	3680'	4-1/2"	4048'	0
Lansing	Gas	3962'	3966'			

Describe in detail the manner in which the well was plugged, indicating where the mud fluid was placed and the method or methods used in introducing it into the hold. If cement or other plugs were used, state the character of same and depth placed, from _____ feet to _____ feet for each plug set.

Pumped 2 sx. of cottonseed hulls, 14 sx. of gel, and 100 sx. 50-50 Pozmix w/6% gel down 4-1/2" casing and 50 sx. 50-50 Pozmix w/6% gel down casing.

(If additional description is necessary, use BACK of this sheet)

Name of Plugging Contractor None

STATE OF OKLAHOMA COUNTY OF OKLAHOMA, ss.

(employee of owner) or (owner or operator) of the above-described well, being first duly sworn on oath, says: That I have knowledge of the facts, statements, and matters herein contained and the log of the above-described well as filed and that the same are true and correct. So help me God.

(Signature) M. E. Shan
2915 Classen Blvd., OKC, OK
 (Address) 73106

SUBSCRIBED AND SWORN TO before me this 26th day of January, 19 83

Helen RECEIVED
 STATE CORPORATION COMMISSION
 Notary Public.

My Commission expires: April 24, 1985

JAN 27 1983
 127-83
 CONSERVATION DIVISION
 Wichita Kansas