

15-039-20001-00-00

STATE OF KANSAS
STATE CORPORATION COMMISSION


Form CP-4

Give All Information Completely
Make Required Affidavit
Mail or Deliver Report to:

WELL PLUGGING RECORD

Conservation Division
State Corporation Commission
P. O. Box 17027
Wichita, Kansas 67217
NORTH

Decatur County, Sec. 14 Twp. 2S Rge. ~~X49~~ 30(W)
Location as "NE/CNWxSWx" or footage from lines. 150' South of C SE SW
Lease Owner Halliburton Oil Producing Company
Lease Name Jording "B" Well No. 1
Office Address 2915 Classen Blvd., Oklahoma City, Okla. 73106
Character of Well (completed as Oil, Gas or Dry Hole) Oil
Date well completed 2-12 1967
Application for plugging filed 9-23 1976
Application for plugging approved 9-29 1976
Plugging commenced 9-22 1976
Plugging completed 9-22 1976
Reason for abandonment of well or producing formation Economic limit

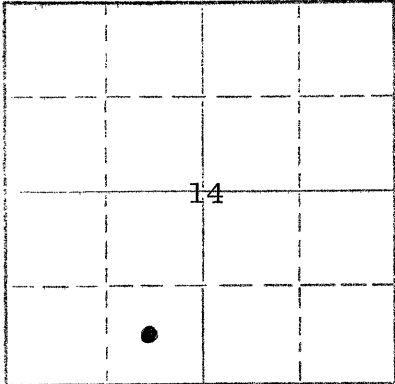

Locate well correctly on above
Section Plat

If a producing well is abandoned, date of last production 6-23 1976
Was permission obtained from the Conservation Division or its agents before plugging was commenced? Yes

Name of Conservation Agent who supervised plugging of this well Gilbert Balthazor
Producing formation Lansing Depth to top 3851' Bottom 3978' Total Depth of Well 4030 Feet
Show depth and thickness of all water, oil and gas formations.

OIL, GAS OR WATER RECORDS

CASING RECORD

FORMATION	CONTENT	FROM	TO	SIZE	PUT IN	PULLED OUT
				7"	320'	None
				4-1/2"	4022'	1612'

Describe in detail the manner in which the well was plugged, indicating where the mud fluid was placed and the method or methods used in introducing it into the hole. If cement or other plugs were used, state the character of same and depth placed, from _____ feet to _____ feet for each plug set.

Filled hole, mixed 2 sx. hulls, 30 sx. cement, 12 sx. gel and pump in hole.
Plug 1380-1680'. Mixed 50 sx. cement plug - 360' back to surface. Cut
off surface and cap well.

RECEIVED
STATE CORPORATION COMMISSION

OCT 08 1976

10-8-76

CONSERVATION DIVISION
Wichita, Kansas

(If additional description is necessary, use BACK of this sheet)
Name of Plugging Contractor D & L Well Service - Supervised by Karol Claypool
Address Box 10, Stafford, Kansas 67578

STATE OF Oklahoma COUNTY OF Oklahoma, ss.
D. D. Swearingen (employee of owner ~~XXXXXXXXXXXX~~) of the above-described
well, being first duly sworn on oath, says: That I have knowledge of the facts, statements, and matters herein contained and the log of the
above-described well as filed and that the same are true and correct. So help me God.

(Signature) D. D. Swearingen, Prod. Supt.
2915 Classen Blvd., Okla. City, Okla.

SUBSCRIBED AND SWORN TO before me this 7th day of October, 1976

My commission expires April 24, 1977

Helen C. Payne
Notary Public.

15-039-20001-Q6-00

CONTRACTOR'S WELL LOG

COMPANY:
CONTRACTOR:
WELL:
LOCATION:

COMMENCED:
COMPLETED:

Halliburton Oil Producing Company
Paine Drilling Co., Inc.
Jording "B" # 1
SE SW Section 14-2S-30W
Decatur County, Kansas
January 24, 1967
February 1, 1967

0	322	Surface Sand & Shale
322	515	Shale
515	1420	Shale & Sand
1420	2345	Shale
2345	2574	Red Bed
2574	2607	Anhydrite
2607	2645	Shale
2645	2870	Shale & Shells
2870	3199	Shale & Lime
3190	3822	Lime & Shale
3822	3955	Lime
3955	4030	Lime & Shale
4030		Rotary Total Depth

9-27-76

Set 7-inch Surface Casing @ 320 ft. with 150 sx cement.

Set 4-1/2-inch Production Casing @ 4022 ft. with 125 sx cement.

We hereby certify that the above is a correct and accurate log of the above mentioned well, as shown on the daily drilling reports.

PAINE DRILLING CO., INC.

BY: *D. F. McPartland*

Subscribed and sworn to before me this 3rd day of February, 1967.

Paul Taylor
Notary Public