

15-039-20316-00-00

STATE OF KANSAS
STATE CORPORATION COMMISSION


Give All Information Completely
Make Required Affidavit
Mail or Deliver Report to:
Conservation Division
State Corporation Commission

P. O. Box 17027
Wichita, Kansas 67217
NORTH

WELL PLUGGING RECORD

Decatur County, Sec. 36 Twp. 2S Rge. 29 (W)

Location as "NE/CNW/SW" or footage from lines NE NE
Lease Owner Abercrombie Drilling, Inc.
Lease Name BREMER Well No. #1
Office Address 801 Union Center, Wichita, Ks.
Character of Well (completed as Oil, Gas or Dry Hole) Dry Hole
Date well completed October 10, 1975
Application for plugging filed (verbally) October 10, 1975
Application for plugging approved (verbally) October 10, 1975
Plugging commenced October 10, 1975
Plugging completed October 10, 1975
Reason for abandonment of well or producing formation No commercial quantity of oil or gas encountered.

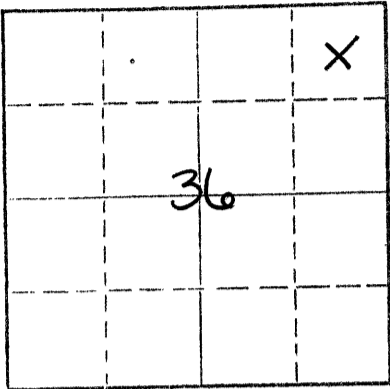

Locate well correctly on above Section Plat

If a producing well is abandoned, date of last production 19
Was permission obtained from the Conservation Division or its agents before plugging was commenced? Yes

Name of Conservation Agent who supervised plugging of this well Gilbert Balthazor
Producing formation _____ Depth to top _____ Bottom _____ Total Depth of Well 3787 Feet
Show depth and thickness of all water, oil and gas formations.

OIL, GAS OR WATER RECORDS

CASING RECORD

| FORMATION | CONTENT | FROM | TO | SIZE | PUT IN | PULLED OUT |
|-----------|---------|------|----|--------|--------|------------|
| | | | | 8 5/8" | 218' | none |
| | | | | | | |
| | | | | | | |
| | | | | | | |
| | | | | | | |
| | | | | | | |
| | | | | | | |
| | | | | | | |
| | | | | | | |

Describe in detail the manner in which the well was plugged, indicating where the mud fluid was placed and the method or methods used in introducing it into the hole. If cement or other plugs were used, state the character of same and depth placed, from _____ feet to _____ feet for each plug set.

1st Plug Set @ 1400' with 70 sx. cement
2nd Plug Set @ 200' with 20 sx. cement
3rd Plug Set @ 40' with 10 sx. cement
Plug was down @ 2:45 a.m. October 10, 1975

RECEIVED
STATE CORPORATION COMMISSION

OCT 15 1975

10-15-75

CONSERVATION DIVISION
Wichita, Kansas

(If additional description is necessary, use BACK of this sheet)

Name of Plugging Contractor Abercrombie Drilling, Inc.
Address 801 Union Center, Wichita, Kansas 67202

STATE OF KANSAS, COUNTY OF SEDGWICK, ss.
Jerry A. Langrehr-Exec. V.P. (employee of owner) or (owner or operator) of the above-described

well, being first duly sworn on oath, says: That I have knowledge of the facts, statements, and matters herein contained and the log of the above-described well as filed and that the same are true and correct. So help me God.

(Signature)

Jerry A. Langrehr
801 Union Center, Wichita, Kansas 67202
(Address)

SUBSCRIBED AND SWORN TO before me this 13th day of October, 19 75

July 21, 1979

Sandra Russell
Sandra Russell

Notary Public.

