


15-039-00071-00-00

Give All Information Completely
Make Required Affidavit
Mail or Deliver Report to:
Conservation Division
State Corporation Commission
800 Bitting Building
Wichita, Kansas

WELL PLUGGING RECORD

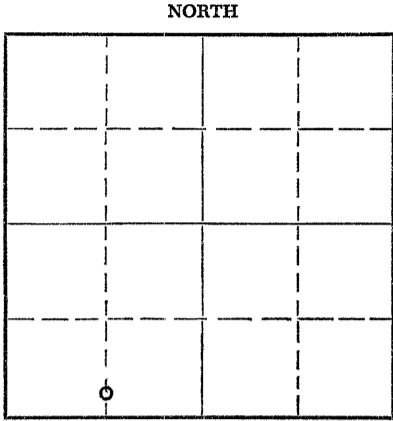

Locate well correctly on above Section Plat

Decatur County, Sec. 33 Twp. 2S Rge. 29W (E) (W)
Location as "NE/CNW/SW" or footage from lines S/2 S/2 SW/4
Lease Owner L. F. Cushenbery
Lease Name Nitsch Well No. 1
Office Address Oberlin, Kansas
Character of Well (completed as Oil, Gas or Dry Hole) Dry Hole
Date well completed September 22, 1953 19
Application for plugging filed September 23, 1953 19
Application for plugging approved September 23, 1953 19
Plugging commenced November 3, 1953 19
Plugging completed November 13, 1953 19
Reason for abandonment of well or producing formation Dry

If a producing well is abandoned, date of last production none 19
Was permission obtained from the Conservation Division or its agents before plugging was commenced? Yes

Name of Conservation Agent who supervised plugging of this well Eldon Petty, Hays, Kansas
Producing formation _____ Depth to top _____ Bottom _____ Total Depth of Well 4228 Feet
Show depth and thickness of all water, oil and gas formations.

OIL, GAS OR WATER RECORDS

CASING RECORD

FORMATION	CONTENT	FROM	TO	SIZE	PUT IN	PULLED OUT
				8-5/8"	193'	None
				5-1/2"	3900	1200'

Describe in detail the manner in which the well was plugged, indicating where the mud fluid was placed and the method or methods used in introducing it into the hole. If cement or other plugs were used, state the character of same and depth placed, from _____ feet to _____ feet for each plug set.

8-5/8" set at 193 feet circulated with cement.
5-1/2" set at 3900 feet with 100 sax cement behind.
Lane Wells plugs to 3779 feet. Top perforations at 3769 feet. Filled hole with chat to 3750 feet. Set 4 sacks cement with dump bailer. Pulled 1200 feet of 5-1/2 inch. Filled hole with mud to 193 feet. Set rock and 15 sacks cement. Filled hole with mud to 35 feet; set rock and 10 sax cement to bottom cellar.

11-24-53

(If additional description is necessary, use BACK of this sheet)


Name of Plugging Contractor J & M Casing Pulling Company
Address Great Bend, Kansas

STATE OF Kansas, COUNTY OF Decatur, ss.

(employee of owner) or (owner or operator) of the above-described well, being first duly sworn on oath, says: That I have knowledge of the facts, statements and matters herein contained and the log of the above-described well as filed and that the same are true and correct. So help me God.
(Signature) L. F. Cushenbery
Oberlin, Kansas (Address)

SUBSCRIBED AND SWORN TO before me this 23rd day of November, 1953

My commission expires May 4, 1955
Emma J. Jay Notary Public.

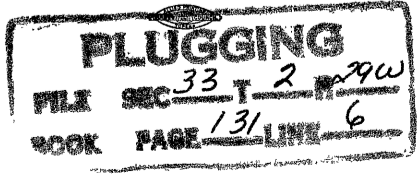

15-039-00071-00-00

Mr. L.F. Cushman
#1 Mitsch
SW SE SW
Section 33-25-29N
Decatur County, Kansas

DEPTH			Minutes	Remarks
From	To			
3400	3410	4-5-6-6-6/6-9-8-6-5		
3410	3420	5-4-2-5-8/6-7-8-5-4		
3420	3430	3-7-7-2-9/7-7-6-4-5		Conn. 7 min. @ 3425
3430	3440	5-5-8-2-3/3-3-4-5-4		Trip: 1:35 @ 3433
3440	3450	5-5-4-3-5/3-5-4-5-3		
3450	3460	3-6-6-4-4/4-5-6-6-4		Conn. 6 min. @ 3435
3460	3470	5-5-5-4-4/4-5-4-5-5		
3470	3480	6-4-4-3-2/3-4-6-4-4		
3480	3490	6-5-3-3-3/3-5-5-4-2		Conn. 5 min. @ 3483
3490	3500	1-1-1-1-3/3-2-3-4-3		
3500	3510	4-4-4-3-5/4-3-5-4-4		
3510	3520	3-4-3-2-5/5-5-4-4-4		Conn. 4 min. @ 3513
3520	3530	4-2-3-3-3/2-3-2-3-3		
3530	3540	3-4-4-3-2/3-4-3-3-4		
3540	3550	3-3-3-3-4/5-5-6-5-5		Conn. 9 min. @ 3543
3550	3560	5-5-4-4-3/4-4-2-1-1		
3560	3570	1-4-4-4-4/4-4-1-2-3		
3570	3580	2-2-2-2-1/2-4-4-5-7		Conn. 4 min. @ 3572
3580	3590	5-4-4-4-4/6-5-5-4-4		
3590	3600	3-5-4-6-6/5-2-1-1-3		
3600	3610	4-3-2-3-3/3-2-2-4-4		Conn. 4 min. @ 3601
3610	3620	3-4-2-3-3/3-4-6-3-3		
3620	3630	5-7-5-7-7/5-5-6-6-4		
3630	3640	2-3-7-7-10/10-9-10-11-10		
3640	3650	10-10-10-10-8/9-7-7-7-5		
3650	3660	8-7-7-5-5/7-6-7-12-8		
3660	3670	8-4-12-12-12/11-14-5-3-5		Conn. ok rig. 7 min. @ 3662; Trip: 2:20 @ 3668
3670	3680	5-5-5-4-6/5-5-6-6-6		
3680	3690	5-6-5-6-5/3-2-1-2-2		
3690	3700	2-2-1-3-1/4-2-2-3-5		
3700	3710	6-5-6-6-5/4-4-6-5-6		
3710	3720	6-6-6-5-5/3-2-4-3-6		
3720	3730	6-4-6-5-7/7-6-6-7-5		Conn. 6 min. @ 3722
3730	3740	7-6-4-4-4/4-6-6-7-6		
3740	3750	6-6-6-5-2/2-2-1-2-3		Dir. 1 1/2 @ 3751; Conn. 4 min. @ 3752
3750	3760	3-3-2-2-3/4-7-6-6-5		
3760	3770	6-7-7-7-7/6-7-6-7-5		
3770	3780	4-3-3-6-5/3-5-6-4-5		Work on pump 12 min. @ 3779
3780	3790	3-3-5-3-5/5-6-6-4-4		
3790	3800	5-5-6-5-6/6-4-5-5-5		
3800	3810	4-6-6-6-5/5-5-5-6-5		
3810	3820	5-5-7-8-6/5-7-6-6-5		Dir. 10 min. @ 3812; DST 8:57 @ 3812
3820	3830	3-2-3-5-6/5-5-7-6-5		Dir. DST 8:41 @ 3830
3830	3840	6-5-7-6-6/5-6-6-6-8		
3840	3850	7-7-6-7-6/7-9-7-7-6		Conn. ok. rig. 6 min. @ 3840
3850	3860	6-6-6-6-4/5-4-4-6-6		
3860	3870	7-6-8-6-6/7-5-7-6-7		
3870	3880	5-6-6-6-7/8-7-6-6-6		Conn. 6 min. @ 3871
3880	3890	6-5-8-7-6/6-6-4-4-5		
3890	3900	4-5-5-5-5/5-5-6-5-5		
3900	3910	6-5-6-6-8/9-6-7-6-8		Conn. 5 min. @ 3902
3910	3920	5-5-7-7-8/8-8-7-6-8		
3920	3930	7-8-7-6-6/5-6-7-5-7		
3930	3940	7-5-6-6-9/8-7-7-7-7		Conn. & P.R. 10 min. @ 3932
3940	3950	7-6-8-8-8/9-8-7-3-1		
3950	3960	1-1-2-1-1/3-3-5-6-7		
3960	3970	6-6-6-7-8/8-7-7-8-10		Conn. 5 min. @ 3963
3970	3980	7-8-8-6-6/6-6-6-8-8		
3980	3990	6-6-7-6-8/7-8-10-7-8		
3990	4000	7-8-9-10-8/6-8-6-7-7		
4000	4010	8-9-8-10-10/10-10-11-10-11		
4010	4020	9-8-9-10-8/7-8-8-10-12		Trip: 2:52 @ 4020
4020	4030	7-6-6-8-5/6-6-8-6-6		
4030	4040	6-6-6-6-6/7-6-7-6-6		
4040	4050	6-5-8-6-6/6-5-4-4-5		Conn. 3 min. @ 4049
4050	4060	4-5-5-8-6/6-6-7-5-7		
4060	4070	7-6-6-5-8/7-7-7-6-8		

Wichita, Kansas
1-18-53

PLUGGING			
FILE	SEC 33	T 2	R 296
BOOK	PAGE 131	LINE	6

15-039-00071-00-00

TIME LOG

L.F. Cushmanbery
#1 Mitsch

<u>DEPTH</u>		<u>Minutes</u>	<u>Remarks</u>
<u>From</u>	<u>To</u>		
h070	h080	7-6-8-10-8/8-8-8-8-8	
h080	h090	10-9-9-15-6/8-9-10-10-9	
h090	h100	11-10-9-8-8/9-11-10-10-10	
h100	h110	10-10-10-8-9/11-8-9-8-8	
h110	h120	7-11-10-12-11/9-5-2-3-4	Conn. 9 min. @ h110
h120	h130	8-8-5-5-4/2-4-3-3-2	
h130	h140	8-7-6-4-3/5-5-4-2-3	Cir. 1:36 @ h129
h140	h150	6-4-4-4-5/5-6-7-4-4	
h150	h160	6-6-7-3-3/4-4-6-4-2	
h160	h170	3-5-5-4-2/2-3-6-6-5	Conn. 5 min. @ h168
h170	h180	5-5-9-6-6/5-4-5-6-7	
h180	h190	6-5-6-6-5/4-6-5-6-9	
h190	h200	8-6-6-2-1/1-1-1-5-7	Cir. 1 1/2 @ h196
h200	h210	6-9-5-5-5/3-1-1-1-6	
h210	h220	8-7-5-4-4/6-5-5-4-4	
h220	h228	4-5-3-5-7/4-4-15	TOTAL DEPTH h228

RECEIVED

11-18-53

PLUGGING
 HOLE NO. 3312-29W
 BOOK PAGE 131 LINE 6