


15-039-00067-00-00

STATE OF KANSAS
STATE CORPORATION COMMISSION

WELL PLUGGING RECORD

Give All Information Completely
Make Required Affidavit
Mail or Deliver Report to:
Conservation Division
State Corporation Commission
800 Bittling Building
Wichita, Kansas

Decatur County. Sec. 36 Twp. 2 Rge. 29 (E) (W)
Location as "NE/CNW%SW%" or footage from lines 330 from W-330 frm s.
Lease Owner Sauvage W. W.
Lease Name Sauvage Well No. 1
Office Address Oberlin, Kansas
Character of Well (completed as Oil, Gas or Dry Hole) dry hole
Date well completed 6-3 1953
Application for plugging filed 6-3 1953
Application for plugging approved 6-3 1953
Plugging commenced 6-3 1953
Plugging completed 6-4 1953
Reason for abandonment of well or producing formation dry

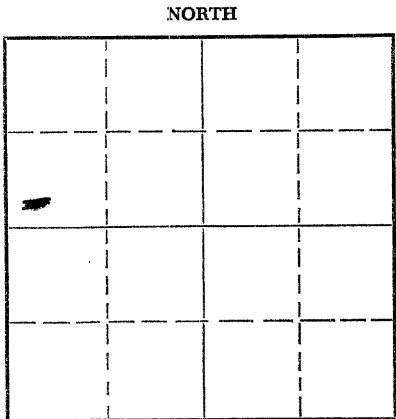

Locate well correctly on above
Section Plat

If a producing well is abandoned, date of last production 6 1953
Was permission obtained from the Conservation Division or its agents before plugging was commenced? yes

Name of Conservation Agent who supervised plugging of this well Eldon Petty
Producing formation _____ Depth to top _____ Bottom _____ Total Depth of Well 4209 Feet
Show depth and thickness of all water, oil and gas formations.

OIL, GAS OR WATER RECORDS

CASING RECORD

FORMATION	CONTENT	FROM	TO	SIZE	PUT IN	PULLED OUT
shale & sand		0	195	12 1/4	195	none
shale & shells		195	2300	7 7/8	none	"
shale & lime		2300	2800	"	"	"
shale & shells		2800	3400	"	"	"
shale & lime		3400	3800	"	"	"
lime & shale		3800	4209	"	"	"

Describe in detail the manner in which the well was plugged, indicating where the mud fluid was placed and the method or methods used in introducing it into the hole. If cement or other plugs were used, state the character of same and depth placed, from _____ feet to _____ feet for each plug set.

Filled the hole with heavy mud on bottom, pulled pipe to 1500 and circulated with heavy mud. Pulled pipe and set plug @ 180ft. and 1/2 sx hulls mixed 15 sx cement through drill pipe and filled with mud to 40 ft. with 1/2 sx hulls and filled surface casing to bottom cellar.

(If additional description is necessary, use BACK of this sheet)

Name of Plugging Contractor Sauvage- Dunn Drilling Co. Inc.
Address Oberlin, Kansas

STATE OF Kansas, COUNTY OF Decatur, ss.
W. W. Sauvage (employee of owner) or (owner or operator) of the above-described well, being first duly sworn on oath, says: That I have knowledge of the facts, statements, and matters herein contained and the log of the above-described well as filed and that the same are true and correct. So help me God.

RECEIVED
STATE CORPORATION COMMISSION

6-6-53

(Signature) W. W. Sauvage

Oberlin, Kansas (Address)

SUBSCRIBED AND SWORN TO before me this 4th day of June, 1953

CONSERVATION DIVISION

Wichita, Kansas

My commission expires May 17, 1955

Opal Sauvage
Notary Public.

