

15-039-00601-00-00

STATE OF KANSAS  
STATE CORPORATION COMMISSION

WELL PLUGGING RECORD

OR

FORMATION PLUGGING RECORD

Strike out upper line when reporting plugging off formations.

Give All Information Completely  
Make Required Affidavit  
Mail or Deliver Report to:  
Conservation Division  
State Corporation Commission  
800 Bittling Building  
Wichita, Kansas

Decatur County, Sec. 16 Twp. 2 Rge. (E) 29 (W)

Location as "NE 1/4 NW 1/4 SW 1/4" or footage from lines Center NW NW SW

Lease Owner Helmerich & Payne, Inc.

Lease Name Penn Well No. 1

Office Address 415 Philtower Building, Tulsa, Oklahoma

Character of Well (completed as Oil, Gas or Dry Hole) Dry

Date well completed 4-20 19 43

Application for plugging filed 4-20 19 43

Application for plugging approved 4-20 19 43


Plugging commenced 4-20 19 43

Plugging completed 4-20 19 43

Reason for abandonment of well or producing formation

If a producing well is abandoned, date of last production 19

Was permission obtained from the Conservation Division or its agents before plugging was commenced? Yes

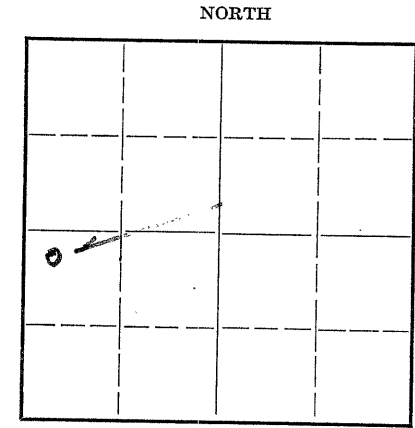

Locate well correctly on above Section Plat

Name of Conservation Agent who supervised plugging of this well C. T. Alexander

Producing formation Depth to top Bottom Total Depth of Well 4302 Feet

Show depth and thickness of all water, oil and gas formations.

OIL, GAS OR WATER RECORDS

CASING RECORD

Formation	Content	From	To	Size	Put In	Pulled Out
Viola	Water	4174	4187	10-3/4"	207'0"	None
Conglomerate	"	4187	4206			
Arbuckle Dolomite	"	4206	4274			
Arbuckle Lime	"	4274	4302			

Describe in detail the manner in which the well was plugged, indicating where the mud fluid was placed and the method or methods used in introducing it into the hold. If cement or other plugs were used, state the character of same and depth placed, from feet to feet for each plug set.

Hole was filled with heavy mud to 207' and a permanent bridge was placed and cemented with 15 sax of cement and filled to 6' of the surface and mudded to the 26 feet of the surface and cemented with 10

PLUGGING  
FILE NO. 16 2-R 29W  
BOOK PAGE 71 LINE 22

STATE CORPORATION COMMISSION  
MAY 5 1943  
TULSA

(If additional description is necessary, use BACK of this sheet)

Correspondence regarding this well should be addressed to Helmerich & Payne, Inc.  
Address 415 Philtower Bldg., Tulsa, Oklahoma

STATE OF OKLAHOMA, COUNTY OF TULSA, SS.

I, C. M. Copeland, (employee of owner) or (owner or operator) of the above-described well, being first duly sworn on oath, says: That I have knowledge of the facts, statements, and matters herein contained and the log of the above-described well as filed and that the same are true and correct. So help me God.

(Signature) C. M. Copeland - Prop

415 Philtower Bldg., Tulsa, Oklahoma.  
(Address)

SUBSCRIBED AND SWORN TO before me this Third day of May, 1943

Sue Griffin  
Notary Public.

My commission expires July 22nd, 1943.

