


WELL PLUGGING RECORD

Give All Information Completely
Make Required Affidavit
Mail or Deliver Report to:
Conservation Division
State Corporation Commission
212 No. Market
Wichita, Kansas

Decatur County, Sec. 30 Twp. 2S Rge. 29 (E) W (W)

Location as "NE/CNW $\frac{1}{4}$ SW $\frac{1}{4}$ " or footage from lines SE SE NW
Lease Owner Oknar Oil Company
Lease Name Pollnow Well No. 1
Office Address 1130 Wichita Plaza, Wichita, Kansas
Character of Well (completed as Oil, Gas or Dry Hole) Dry Hole
Date well completed 5-3 19 68
Application for plugging filed 5-3 19 68
Application for plugging approved 5-3 19 68
Plugging commenced 5-3 19 68
Plugging completed 5-3 19 68
Reason for abandonment of well or producing formation Dry Hole

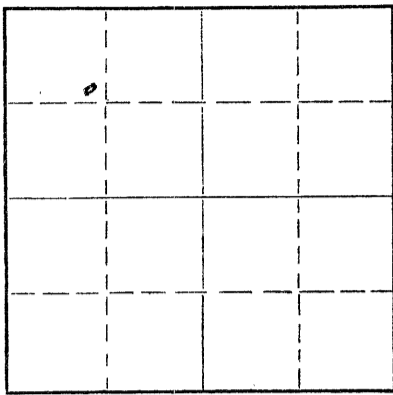

Locate well correctly on above Section Plat

If a producing well is abandoned, date of last production 19
Was permission obtained from the Conservation Division or its agents before plugging was commenced? Yes

Name of Conservation Agent who supervised plugging of this well W. L. Nichol
Producing formation _____ Depth to top _____ Bottom _____ Total Depth of Well 4058 Feet
Show depth and thickness of all water, oil and gas formations.

OIL, GAS OR WATER RECORDS

CASING RECORD

FORMATION	CONTENT	FROM	TO	SIZE	PUT IN	PULLED OUT
		0	326	7"	315.72	

Describe in detail the manner in which the well was plugged, indicating where the mud fluid was placed and the method or methods used in introducing it into the hole. If cement or other plugs were used, state the character of same and depth placed, from _____ feet to _____ feet for each plug set.

1st plug at 1735 W/65 sacks cement
2nd plug at 330' W/15 sacks cement
3rd plug at 40' to top W/5 sacks cement

RECEIVED
STATE CORPORATION COMMISSION
MAY 10 1968
CONSERVATION DIVISION
Wichita, Kansas


5-10-68

(If additional description is necessary, use BACK of this sheet)
Name of Plugging Contractor Sun Cementing Co
Address _____

STATE OF Kansas, COUNTY OF Graham, ss.
Louis Edgett (employee of owner) or (owner or operator) of the above-described well, being first duly sworn on oath, says: That I have knowledge of the facts, statements, and matters herein contained and the log of the above-described well as filed and that the same are true and correct. So help me God.

(Signature) Louis Edgett
Louis Edgett, Bookkeeper
P. O. Box D, Hill City, Kansas
(Address)

SUBSCRIBED AND SWORN TO before me this 9th day of May, 1968

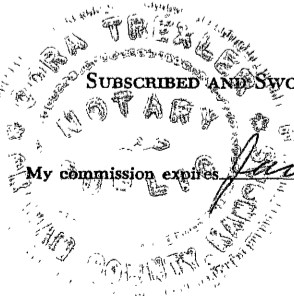

Carol Taylor
Notary Public.