


Give All Information Completely
Make Required Affidavit
Mail or Deliver Report to:
Conservation Division
State Corporation Commission
211 No. Broadway
Wichita, Kansas

15-039-00093-00-00

WELL PLUGGING RECORD

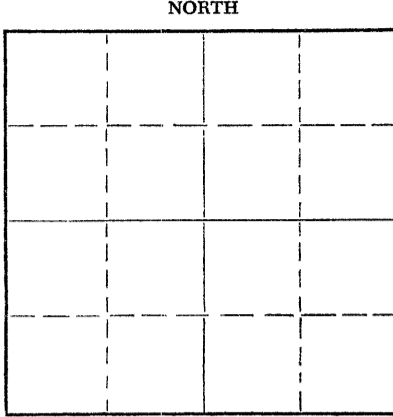

Locate well correctly on above Section Plat

Decatur County. Sec. 25 Twp. 2S Rge. 29W (E) (W)
Location as "NE/CNW/SW" or footage from lines NE NE SE
Lease Owner Sauvage Drilling Co., Inc.
Lease Name Eiler (Eiler) Well No. 1
Office Address Oberlin, Kansas
Character of Well (completed as Oil, Gas or Dry Hole) Dry Hole
Date well completed 9-26-60 19
Application for plugging filed 9-26-60 19
Application for plugging approved 9-26-60 19
Plugging commenced 9-26-60 19
Plugging completed 9-26-60 19
Reason for abandonment of well or producing formation Dry

If a producing well is abandoned, date of last production _____ 19____
Was permission obtained from the Conservation Division or its agents before plugging was commenced? Yes

Name of Conservation Agent who supervised plugging of this well Al Fabricius, Hill City, Kansas
Producing formation _____ Depth to top _____ Bottom _____ Total Depth of Well 4172 Feet
Show depth and thickness of all water, oil and gas formations.

OIL, GAS OR WATER RECORDS

CASING RECORD

FORMATION	CONTENT	FROM	TO	SIZE	PUT IN	PULLED OUT
	Surface casing		128	8-5/8"	128	none

Describe in detail the manner in which the well was plugged, indicating where the mud fluid was placed and the method or methods used in introducing it into the hole. If cement or other plugs were used, state the character of same and depth placed, from _____ feet to _____ feet for each plug set.

Filled with mud to 450 feet - set plug with 20 sax cement - filled with mud to 250 feet - set plug with 20 sax cement - filled with mud to 40 feet - set plug with 10 sax cement and fill with mud to bottom of cellar.

RECEIVED
STATE CORPORATION COMMISSION

SEP 30 1960

9-30-60

CONSERVATION DIVISION
Wichita, Kansas

(If additional description is necessary, use BACK of this sheet)

Name of Plugging Contractor Sauvage Drl'g Co - Co tools
Address Oberlin, Kansas

STATE OF Kansas, COUNTY OF Decatur, ss.

(employee of owner) or (owner or operator) of the above-described well, being first duly sworn on oath, says: That I have knowledge of the facts, statements, and matters herein contained and the log of the above-described well as filed and that the same are true and correct. So help me God.

(Signature) Keith Gallatin
Keith Gallatin
Oberlin, Kansas
(Address)

SUBSCRIBED AND SWORN TO before me this 28 day of September, 19 60

My commission expires June 18, 1960

Janice Bryan
Notary Public.



15-039-00093-00-00

OPERATOR Sauvage Dril'g Co
FARM Eiler
WELL NO. 1
CONTRACTOR Co tools
ROTARY COMM. 9-16-60
ROTARY COMP. 9-26-60

LOCATION NE NE SE 25-2S-29W
Decatur Co Kansas
Casing record:
128' - 8-5/8" sur csg
Total depth 4172
Elevation KB 2605 - GL 2600

Figures denote bottom of formations

Sand & shale	430
Shale	1327
Shale & shells	1901
Pyrite, gyp & shale	2017
Shale & sand	2292
Shle & sand	
Anhydrite	2328
Lime & shale	2600
Shale & shells	2830
Lime	3075
Lime & shale	3355
Lime & shells	3375
Lime & shale	3600
Lime	3637
Lime & shale	4135
Lime	4172 TD

RECEIVED
STATE CORPORATION COMMISSION
SEP 30 1960
CONSTRUCTION DIVISION

STATE OF KANSAS)
DECATUR COUNTY) SS

I hereby certify that the foregoing is, to the best of my knowledge and belief, a true and correct drilling log as shown by the drilling reports of the aforesaid well.

Keith Gallitan
KEITH GALLITAN, Oberlin, Kansas

Subscribed and sworn to before me, the undersigned, a Notary Public, this 28 day of September, 1960.

Francis Bryan
Notary Public

My commission expires June 18, 1962