

STATE OF KANSAS
STATE CORPORATION COMMISSION
200 Colorado Derby Building
Wichita, Kansas 67202

WELL PLUGGING RECORD
K.A.R.-82-3-117

API NUMBER 15-039-20,307

LEASE NAME Berndt #4 SWD

WELL NUMBER _____

SPOT LOCATION C E/2 SE

SEC. 35 TWP. 2 RGE. 30w(E) or (W)

COUNTY Decatur

Date Well Completed _____

Plugging Commenced 2/19/86

Plugging Completed 2/19/86

TYPE OR PRINT
NOTICE: Fill out completely
and return to Cons. Div.
office within 30 days.

LEASE OPERATOR A.L. Abercrombie, Inc.

ADDRESS 801 Union Center, Wichita, Ks. 67202

PHONE # (316) 262-1841 OPERATORS LICENSE NO. 5393

Character of Well _____
(Oil, Gas, D&A, SWD, Input, Water Supply Well)

Did you notify the KCC/KDHE Joint District Office prior to plugging this well? Yes

Which KCC/KDHE Joint Office did you notify? Hays

Is ACO-1 filed? _____ If not, is well log attached? _____

Producing formation _____ Depth to top _____ bottom _____ T.D. 4000'

Show depth and thickness of all water, oil and gas formations.

OIL, GAS OR WATER RECORDS

CASING RECORD

Formation	Content	From	To	Size	Put in	Pulled out
				10 3/4	250'	none
				7"	2531'	none

Describe in detail the manner in which the well was plugged, indicating where the mud fluid was placed and the method or methods used in introducing it into the hole. If cement or other plugs were used state, the character of same and depth placed, from _____ feet to _____ feet each set.

Plug job only - No pipe recovery. Plugged well with 5 hulls, 10 gel, & 300 sacks 60/40 poz 6% gel 3% c.c.

Plugging complete.

(If additional description is necessary, use BACK of this form.)

Name of Plugging Contractor Kelso Casing Pulling License No. 6050

Address Box 347, Chase, Ks. 67524

STATE OF Kansas COUNTY OF Rice, ss.

R. Darrell Kelso

(employee of operator) or


(operator) of above-described well, being first duly sworn on oath, says: That I have knowledge of the facts, statements, and matters herein contained and the log of the above-described well as filed that the same are true and correct, so help me God.

(Signature) R. Darrell Kelso

(Address) Box 347, Chase, Ks. 67524

SUBSCRIBED AND SWORN TO before me this 24th day of February, 19 86

My Commission expires:

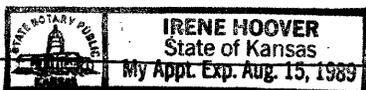

RECEIVED
Irene Hoover
Notary Public
STATE CORPORATION COMMISSION
2-26-86

FEB 26 1986

Form CP-4
Revised 01-84

CONSERVATION DIVISION

0001

KANSAS DRILLERS LOG

API No. 15 — 039 — 20,307-0007
 County Number

S. 35 T. 2S R. 30

Loc. C E/2 SE/4

Operator
 A. L. Abercrombie, Inc.

County Decatur
 640 Acres
 N

Address
 801 Union Center, Wichita, Kansas 67202


Well No. #4 Lease Name BERNDT

Footage Location
 1320 feet from (N) (S) line 660 feet from (E) (W) line

Principal Contractor Abercrombie Drilling Geologist Charles Johnson

Spud Date June 4, 1975 Total Depth 4000' P.B.T.D.

Date Completed June 13, 1975 Oil Purchaser

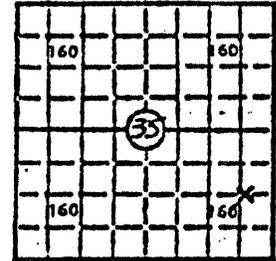

Locate well correctly
 Elev.: Gr. 2743
 DF 2749 KB 2751

CASING RECORD

Report of all strings set— surface, intermediate, production, etc.

Purpose of string	Size hole drilled	Size casing set (in O.D.)	Weight lbs/ft.	Setting depth	Type cement	Sacks	Type and percent additives
Surface	13 3/4"	10 3/4"		250'	Sunset	170	None
Disposal		7"	23#	2531'	50/50 Posmix	450	6% gel
					Common	75	None

LINER RECORD

PERFORATION RECORD

Top, ft.	Bottom, ft.	Sacks cement	Shots per ft.	Size & type	Depth interval
			2		2300-2330

TUBING RECORD

Size	Setting depth	Pecker set at

ACID, FRACTURE, SHOT, CEMENT SQUEEZE RECORD

Amount and kind of material used	Depth interval treated
None	

INITIAL PRODUCTION

Date of first production	Producing method (flowing, pumping, gas lift, etc.) Injection Test - 2 bbls. per minute
RATE OF PRODUCTION PER 24 HOURS	Oil bbls. Gas MCF Water bbls. Gas-oil ratio CFPB
Disposition of gas (vented, used on lease or sold)	Producing interval(s)

INSTRUCTIONS: As provided in KCC Rule 82-2-125, within 90 days after completion of a well, one completed copy of this Drillers Log shall be transmitted to the State Geological Survey of Kansas, 4150 Monroe Street, Wichita, Kansas 67209. Copies of this form are available from the Conservation Division, State Corporation Commission, 3830 So. Meridian (P.O. Box 17027), Wichita, Kansas 66217. Phone AC 316-522-2205. If confidential custody is desired, please note Rule 82-2-125. Drillers Logs will be on open file in the Oil and Gas Division, State Geological Survey of Kansas, Kansas 66044.