

STATE OF KANSAS
STATE CORPORATION COMMISSION


15-039-20619-00-00

WELL PLUGGING RECORD

Give All Information Completely
Make Required Affidavit
Mail or Deliver Report to
Conservation Division
State Corporation Comm.
245 North Water
Wichita, KS 67202

Decatur County, Sec. 32 Twp. 2S Rge. 30 x E/W
Location as "NE/CNW 1/4 SW 1/4" or footage from lines

NW NE
Lease Owner Abraxas Petroleum Corporation
Lease Name Euhus Well No. #1
Office Address 1100 N.E. Loop 410, P. O. Box 17485, San Antonio, Texas
Character of Well (Completed as Oil, Gas or Dry Hole)
Dry Hole
Date Well completed 12-2-81 19
Application for plugging filed 12-2-81 19
Application for plugging approved 12-2-81 19
Plugging commenced 12-2-81 19
Plugging completed 12-2-81 19

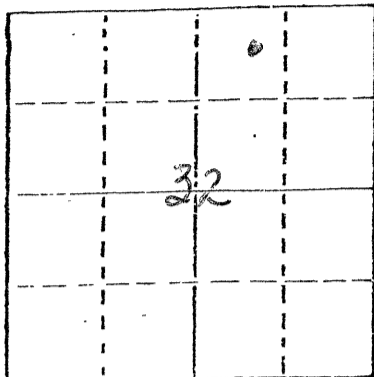

Locate well correctly on above Section Plot

Reason for abandonment of well or producing formation
Commercial quantities of oil not found
If a producing well is abandoned, date of last production 19.

Was permission obtained from the Conservation Division or its agents before plugging was commenced? Yes

Name of Conservation Agent who supervised plugging of this well Carl Goodrow
Producing formation Depth to top Bottom Total Depth of Well 4175'
Show depth and thickness of all water, oil and gas formations.

OIL, GAS OR WATER RECORDS

CASING RECORD

FORMATION	CONTENT	FROM	TO	SIZE	PUT IN	PULLED OUT
				8 5/8"	227'	None

Describe in detail the manner in which the well was plugged, indicating where the mud fluid was placed and the method or methods used in introducing it into the hold. If cement or other plugs were used, state the character of same and depth placed, from feet to feet for each plug set.

Plug @ 1860' w/70 sx.
Plug @ 220' w/45 sx.
Rat Hole 10 sx.

RECEIVED
STATE CORPORATION COMMISSION
12-14-1981
DEC 14 1981

CONSERVATION DIVISION
Wichita, Kansas

(If additional description is necessary, use BACK of this sheet)

Name of Plugging Contractor Rains & Williamson Oil Co., Inc.

STATE OF Kansas COUNTY OF Sedgwick, ss.

Wilson Rains, President of Rains & Williamson Oil Co., Inc. (employee of owner) or (owner or operator) of the above-described well, being first duly sworn on oath, says: That I have knowledge of the facts, statements, and matters herein contained and the log of the above-described well as filed and that the same are true and correct. So help me God.

(Signature) _____
435 Page Court, 220 W. Douglas, Wichita, Ks. 67202
(Address)

SUBSCRIBED AND SWORN TO before me this 4 day of December, 1981

My commission expires 10-4-83

Juanita M. Green
Notary Public.



DRILLER'S LOG

15-039-20619-00-00

COMPANY: Abraxas Petroleum Corporation

SEC. 32 T. 2S R. 30W

LOC. NW NE

WELL NAME: Euhus #1

COUNTY: Decatur

RIG NO. #11

TOTAL DEPTH 4175'

ELEVATION 2888 GR.

COMMENCED: 11-17-81 COMPLETED: 12-2-81

CONTRACTOR: Rains & Williamson Oil Co., Inc.

CASING RECORD:

SURFACE: 8 5/8" @ 227' w/170 sx. 60/40 poz., 2% gel, 3%

PRODUCTION: D&A

RECEIVED
STATE CORPORATION COMMISSION

DEC 14 1981
12-14-1981
CONSERVATION DIVISION
Wichita, Kansas

LOG

(Figures Indicate Bottom of Formations)

Shale & Sand	437
Shale	2050
Sand, Shale & Lime	2689
Shale & Lime	2875
Shale	3133
Sand & Shale	3230
Shale & Sand	3455
Shale & Lime	3700
Lime & Shale	4114
Lime	4175
<u>ROTARY TOTAL DEPTH</u>	<u>4175</u>

STATE OF Kansas)
COUNTY OF Sedgwick) SS:

I, Wilson Rains, President of Rains & Williamson Oil Co., Inc.
upon oath state that the above and foregoing is a true and correct copy of the log of the
Euhus #1 well.

Wilson Rains
Wilson Rains

Subscribed and sworn to before me this 4 day of December, 1981.



My Appointment Expires:
10-4-83

Juanita M. Green
Juanita M. Green